


CERTIFIED RECORD OF LAND CORNER MONUMENTATION

Index File Number M-16

History of original corner establishment:

Not Set.

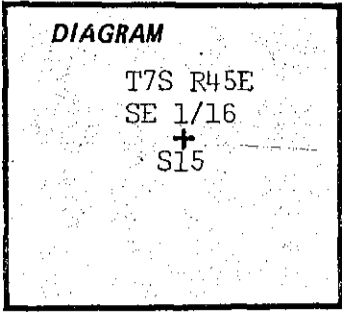

Description of corner evidence found:

None Found.

Description of monument and accessories established to perpetuate the original location of this corner:

At surveyed point set 2 1/2" X 30" galvanized pipe and brass cap marked:  
Set pipe 24" in the ground and mound of stone around to cap.

T7S R45E  
SE 1/16  
+  
S15  
OR PLS 1051  
1982

From which by magnetic declination of N20°E:  
An 11" Tamarack bears S03°W, 24.4 ft. scribed SE 1/16 S15 BT.  
A 9" Fir bears N41°W, 33.9 ft. scribed SE 1/16 S15 BT. Painted blazes red and 6" red band around. Placed 54-3s, 54-9s and brass washers stamped PLS 1051 on the bearing trees. Placed 54-2 and 54-9 on a steel fence post 5' south and placed 54-2 on a steel fence post 5' west of the corner.

I hereby certify that the above corner monument was established as herein described.

Witnesses: Larry D. Shirley  
Terry J. Anderson

September 13, 1982.

REGISTERED  
PROFESSIONAL  
LAND SURVEYOR

*Barry B. Barbour*  
OREGON  
OCT. 17, 1975  
BARRY B. BARBOUR  
1051

Office of.....County Surveyor..... County of.....Baker.....

State of.....Oregon..... I hereby certify that the within instrument was filed in this office

for record on the..... day of....., 19.85

..... by .....  
(COUNTY OFFICIAL) (DEPUTY)

Form R6-7100-57 (9/71)

☆U.S. GOVERNMENT PRINTING OFFICE-1983-793-278

FILED 11-7-85  
BAKER COUNTY SURVEYOR  
SURVEY NO. 7-45-138