


CERTIFIED RECORD OF LAND CORNER MONUMENTATION

History of original corner establishment:

Not previously established.

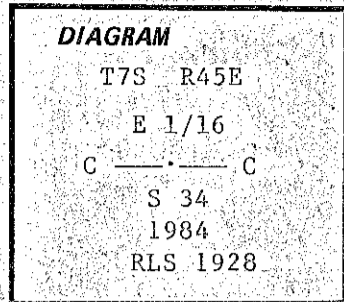

Description of corner evidence found:

Not previously established.

Description of monument and accessories I established to perpetuate the original location of this corner:

Set 30" long aluminum pipe with 3 1/2" aluminum cap, marked as shown above, 8" above ground with rock collar. Steel post with 54-2 & 54-9 signs next to cap.

Scribed:

8" Pine N.71°E. 17.7' "C-E 1/16 S34 BT"

12" Pine S.37°E. 32.7' "C-E 1/16 S34 BT"

Attached signs 54-3 & 54-9 and nailed aluminum washers stamped "RLS 1928" by "BT" scribe on trees. Painted blazes red and a 6" red bad around both trees.

REGISTERED
PROFESSIONAL
LAND SURVEYOR
1-20-86
Duane Fehringer
OREGON
JULY 13, 1984
DUANE FEHRINGER
2118

Office of..... County of.....
State of..... I hereby certify that the within instrument was filed in this office
for record on the..... day of....., 19....
..... by

(COUNTY OFFICIAL)

(DEPUTY)

FILED May 9, 1986
BAKER COUNTY SURVEYOR
SURVEY NO. 7-45-113