


CERTIFIED RECORD OF LAND CORNER MONUMENTATION

HISTORY OF ORIGINAL CORNER ESTABLISHMENT:

GRANITE BOULDER 14" x 12" x 8", 10" IN GROUND
MARKED 1/4 ON NORTH SIDE

A 9" COTTONWOOD BEARS S5°W 73 LKS MARKED
1/4 B.T.

A 4" COTTONWOOD BEARS N8°E 5LKS MARKED
1/4 BT

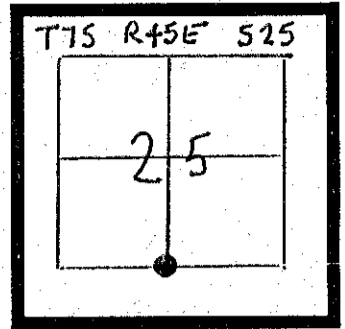

DIAGRAM

DESCRIPTION OF CORNER EVIDENCE FOUND:


NONE CORNER POSITION ESTABLISHED BY SURVEY
SEE CS 7-45-146 & MLP 1996-020

DESCRIPTION OF MONUMENT AND ACCESSORIES ESTABLISHED
TO PERPETUATE THE ORIGINAL LOCATION OF THIS CORNER:

SET 5/8" x 30" IRON ROD WITNESS CORNER, WITH A 2"
ALUMINUM CAP MARKED AS SHOWN, SET AT GROUND LEVEL.

WITNESS CORNER IS 500' WESTERLY OF 1/4 CORNER POSITION ON
SECTION LINE. TRUE CORNER FALLS IN ROOT WIND OF
FALLEN TREE.

- SET 5/8" IRON ROD WITH YELLOW PLASTIC CAP, N51°E, 12.9'
- SET 5/8" IRON ROD WITH YELLOW PLASTIC CAP, S64°E, 10.6'
- SET 5/8" IRON ROD WITH YELLOW PLASTIC CAP, S76°W, 5.5'
- SET 5/8" IRON ROD WITH YELLOW PLASTIC CAP, N22°W, 8.2'

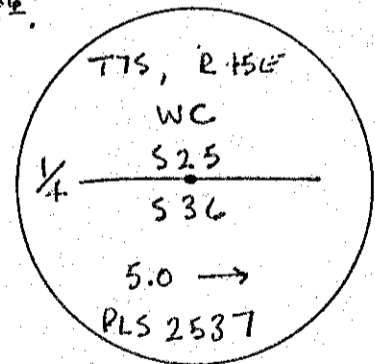

I hereby certify that the above corner point was
perpetuated as hereon described on 27 November 1996

Witnesses:

ROD LEWIS
PETER ELDER
DOUG THOMAS

REGISTERED
PROFESSIONAL
LAND SURVEYOR

H. M. [Signature]

OREGON
JAN. 21, 1992
HARMON E. McLENDON
2537

Renews 12/31/96

FILED 12-19-96
BAKER COUNTY SURVEYOR
SURVEY NO. 7-45-150