


RECORD OF LAND CORNER MONUMENTATION

Description of corner evidence found and history:

Corner not previously set.

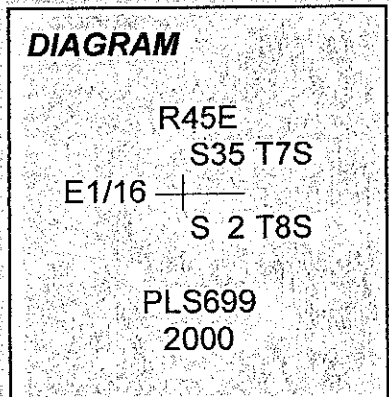

Description of monument and accessories I established to perpetuate the original location of this corner:

I set a 30" long No. 5 Rebar 26" in the ground with a yellow plastic cap marked PLS 699 at the location computed by subdividing a section in accordance with the BLM "Manual of Instructions for the Survey of Public Lands" in the drain ditch on the North side of Baker County Road No. 964.

I placed a PK nail with an aluminum washer stamped PLS 699 on the NE face at the base of a power pole which bears S46°W, 48.1 feet from the corner monument.

I placed a PK nail with an aluminum washer stamped PLS 699 on the top of the SW bridge guard post which bears S68°E, 86.5 feet from the corner monument.

REGISTERED
PROFESSIONAL
LAND SURVEYOR

Leland Lee Myers

OREGON
JULY 9, 1965
LELAND LEE MYERS
699

Renewal Date 1/1/2001

BAKER COUNTY SURVEYOR
RECEIVED APRIL 6, 2000
FILED APRIL 6, 2000
SURVEY No. 7-45-153
DWG. No. _____
INDEX No. **T7S R45E Z-20**