


RECORD OF LAND CORNER MONUMENTATION

CORNER: SE1/16 SEC. 25, TWP. 7 S., RANGE 45 E., W.M.

ORIGINAL SURVEY BY: CORNER NOT

CONTRACT NUMBER: PREVIOUSLY

CONTRACT DATE: ESTABLISHED

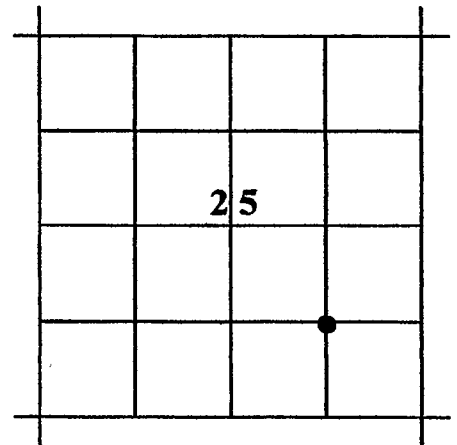


ORIGINAL DESCRIPTION: NONE

DESCRIPTION OF MONUMENTS AND ACCESSORIES SET AND METHODS USED:

At the corner point as located by survey, set a 5/8"x30" iron pin, 32" in the gravel road surface, with attached 2" diameter aluminum cap marked as shown.

From which, I SET THE FOLLOWING REFERENCE POINTS:

- ▶ A 5/8"x30" iron pin bears N.76°11'E., 37.91 ft., with attached yellow plastic cap marked "BENCHMARK SURVEYING"
- ▶ A 5/8"x30" iron pin bears N.00°01'24"W., 30.00 ft., with attached yellow plastic cap marked "BENCHMARK SURVEYING"

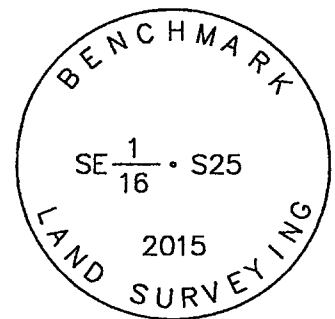


Used RTK GPS to measure the RP's. See Survey dated October 6, 2015, filed in the Baker County Surveyor's Office.

RESTORATION BY, STAMP AND DATE:

Work performed October 6, 2015 by:
Jason L. Hatfield, PLS
Marcus R. Teague, Survey Technician

Benchmark Land Surveying, Inc.
2101 Main Street, Suite 223
Baker City, OR 97814
(800) 699-0516

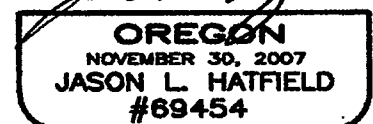

EXPIRES: 6/30/2017

FILED Oct. 28, 2015
BAKER COUNTY SURVEYOR
SURVEY NO. 7-45-171