


RECORD OF LAND CORNER MONUMENTATION

WEST 1/16 CORNER BETWEEN SECTION 34, T. 6 S., R. 45 E., W.M., AND SECTION 3, T.7S., R.45E., W.M.

ORIGINALLY ESTABLISHED BY: James H. Hambleton, PLS 645 in 1976. See Map of Survey filed March 22, 1977 in the Baker County Surveyor's office as Survey No. 7-45-5, and corner monumentation record filed March 23, 1981 as Survey No. 7-45-69

SUBSEQUENT SURVEYS:

► Survey by Philip G. Griffin, Cadastral Surveyor for the Bureau of Land Management, completed August 30, 1994, approved July 7, 1997 under Group No. 1650

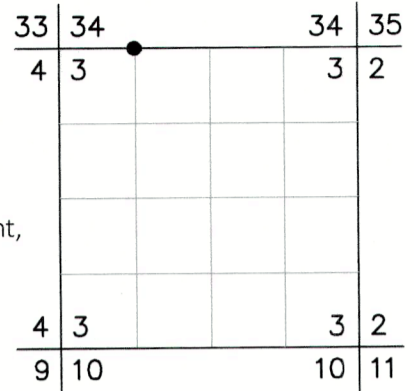

HAMBLETON'S DESCRIPTION: I set a Brass Cap on a 2" pipe 30" long and flared at the bottom. I stamped the cap as shown in the above diagram and buried the monument in a mound of stone. From which I set two bearing trees:

A larch 8" in dia. which bears N 26 00 W, 43.75 feet and scribed 1/16 S 34 BT.
 A pine 9" in dia. which bears S 21 00 W, 25.65 feet and scribed 1/16 S 3 BT.

B.L.M. DESCRIPTION: The W 1/16 sec. cor. of secs. 3 and 34, established by James H. Hambleton, Registered Land Surveyor No. 645, in 1976, of which I have no record, accepted as the corner, monumented with an iron post, 2½ ins. diam., firmly set, projecting 12 ins. above ground, and in a collar of stone, with brass cap mkd. (diagram shown) from which bearing trees by Hambleton


A ponderosa pine, 16 ins. diam., bears S. 22° W., 39 lks. dist., with healed double blaze.
 A larch, 15 ins. diam., bears N. 27° W., 65 lks. dist., with healed double blaze.

EVIDENCE FOUND: Found a 2½" galvanized iron pipe with 2½" brass cap attached (marked as shown below), projecting 14" above ground in a loose 2 ft. mound of stone.

CORNER MONUMENT MARKED:

From which, **THE BEARING TREES BY HAMBLETON:**

- A ponderosa pine, 21" dbh bears S.22°W., 25.83 ft., with healed double blaze
- A western larch, 15" dbh, bears N.27°W., 43.28 ft., with healed double blaze

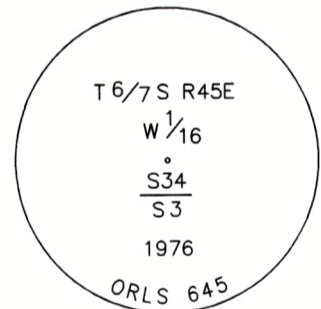

Rebuilt the mound of stone, 3 ft. diameter base to top of cap. Painted a 6 inch red band around the bearing trees, and also painted blazes red. Used a staff compass with 14° East declination to measure bearings to BT's. Distances were measured with a steel tape, measuring to a 60d nail driven in the side-center-right at the root crown of each tree, with an attached 1½" aluminum washer stamped PLS 69454. Attached new USFS 54-3 signs to BT's with updated information.


RESTORATION BY, STAMP AND DATE:

Work Performed October 24, 2022 by:

Jason L. Hatfield, PLS
 Daniel B. Lee

USDA FOREST SERVICE
 NORTHEAST OREGON LAND ZONE
 1550 Dewey Avenue, Suite A
 Baker City, OR 97814
 (541) 523-1283

FILED December 14, 2022
 BAKER COUNTY SURVEYOR
 SURVEY NO. 6-45-180 (Z-14)
7-45-198

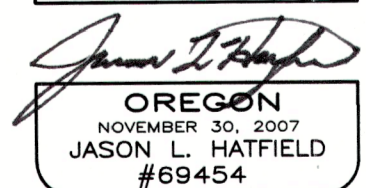

EXPIRES: 6/30/2023