

RECORD OF LAND CORNER MONUMENTATION

NORTHEAST CORNER OF SECTION 22, T. 7 S., R. 45 E., W.M.


ORIGINALLY ESTABLISHED BY: W.B. Barr, U.S. Deputy Surveyor

CONTRACT NUMBER: 443

CONTRACT DATE: May 29, 1882

SUBSEQUENT SURVEYS:

- ▶ Remonumentation of Certian Original Corner Points, Township 7 South, Range 45 East, performed by A. Joseph Garrison, Cadastral Surveyor under Group No. 350 and approved on June 13, 1977.
- ▶ Survey by Barry B. Barbour, PLS 1051, filed as Survey No. 07-45-6, recorded on August 25, 1978.

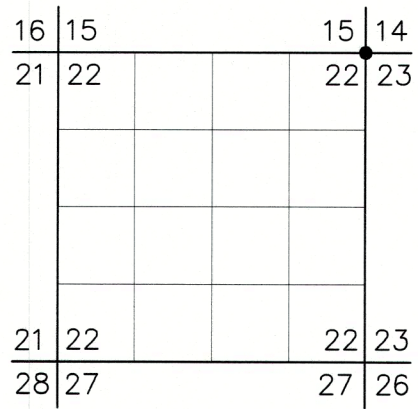

ORIGINAL DESCRIPTION:

Set granite boulder 17x11x5 ins, 12 inches in ground for corner to Sec 14, 15, 22, 23 marked with 3 notches on the south and 2 notches on the east edges.

From which:

- A pine 18" diam bears N81°E, 95 lks dist marked T7SR45ES14BT.
- A pine 48" diam bears N23°W, 130 lks dist marked T7SR45ES15BT.
- A pine 22" diam bears S15°W, 82 lks dist marked T7SR45ES22BT.
- A pine 14" diam bears S55°E, 140 lks dist marked T7SR45ES23BT.

GARRISON'S DESCRIPTION:

The cor. of secs. 14, 15, 22, and 23, determined at record bearing and distance from the remains of the original bearing trees: A pine, 33" diam., bears S.15°W., 82 lks. dist., with scribe marks 45 S visible on partially healed blaze. At corner point: Set an iron post, 28" long, 2½" diam., 24" in the ground, with brass cap mkd.

From which new bearing trees:

- A white fir, 25" diam., bears N.14°E., 16 lks dist. mkd. T7S R45E S14 BT.
 - A pine, 32" diam., bears S.45¼°E., 168 lks dist. mkd. T7S R45E S23 BT.
 - A pine, 18" diam., bears N.65¾°W., 204 lks dist. mkd. T7S R45E S15 BT.
- Corner is located on E. edge of Pine Creek Road, bears N.30°W and S.30°E.

T7S R45E
S15 | S14
S22 | S23
1975

BARBOUR'S DESCRIPTION:

Found Corner (BLM Brass Cap)

EVIDENCE FOUND: I search for but do not find the iron pipe and brass cap. Monument most likely destroyed by road maintenance activities. Found 4 bearing trees with healed blazes.

DESCRIPTION OF MONUMENTS AND ACCESSORIES SET AND METHODS USED:

At the best fit of distances from found bearing trees, I set a 5/8" x 24" iron rod with attached 3/4" aluminum cap 36" in the ground, 12" into bedrock. Cap marked as shown. Monument lies in the ditch on the east side of State Highway 413.

From which, **GARRISON'S BEARING TREES:**


- ▶ A white fir, 43" dbh, bears N.21°E., 10.53 ft., with a healed blaze in good condition.
- ▶ A ponderosa pine, 40" dbh, bears S.36°E., 110.27 ft., with a healed blaze in good condition.
- ▶ A ponderosa pine, 36" dbh, bears S.24°W., 54.11 ft., with a healed blaze in poor condition.
- ▶ A ponderosa pine, 32" dbh, bears N.57°E., 134.11 ft., with a healed blaze in good condition.

Also from which, **I SET NEW REFERENCE MONUMENTS:**

- ▶ A 5/8" x 24" iron rod, bears S.12°W., 57.36 ft., with attached 2" aluminum cap marked *RM 1 2023 PLS 91693*.
- ▶ A 5/8" x 24" iron rod, bears S.82°W., 38.36 ft., with attached 2" aluminum cap marked *RM 2 2023 PLS 91693*.

Painted a 6 inch red band around each bearing tree, and also painted blazes red and attached USFS 54-3 and 54-9 signs as needed. Distances measured with total station. Bearings measured with a handheld compass with 14° East declination.

CORNER MONUMENT
MARKED:

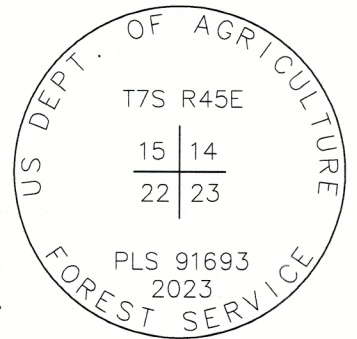

RESTORATION BY, STAMP AND DATE:

Work Performed October 12, 2023 by:

T. DeJesus Quinones, LSIT
Vincent L. Kelly
Spencer B. Jones

USDA FOREST SERVICE
NORTHEAST OREGON LAND ZONE
1550 Dewey Avenue, Suite A
Baker City, OR 97814
(541) 523-1281

FILED *January 24 2024*
BAKER COUNTY SURVEYOR
SURVEY NO. *7-45-202*

REGISTERED
PROFESSIONAL
LAND SURVEYOR

[Signature]
OREGON
SEPTEMBER 11, 2018
ROBERT C. MOYERS
#91693

RENEWS: 12/31/2024