


CERTIFIED RECORD OF LAND CORNER MONUMENTATION

Page 1 of 1

CORNER DATA			
Date Set/Visited:	09/11/2024	Northing:	
Date Prepared:	09/13/2024	Easting:	
Corner Code(s):	R5	Latitude:	
DLC/Government Lot:	Not Applicable	Longitude:	
Township & Range:	T7S R45E	Basis of Bearings:	
Section(s):	19, 20, 29, 30	Equipment:	Brunton Geo Transit
County:	Baker	Magnetic Declination:	13°30'
Coordinate System:	NAD83/2011	Recovered By:	Greg Engलगau
Zone:	Oregon North 3601	Witness(es):	Eric Hyatt
Units:	International Feet		

CORNER HISTORY
Record of Original Corner
Set Basalt rock 12x12x10, 8 inches in ground on hillside facing east, for corner to Sec 19,20,29,30 marked with 2 notches on the south and 5 notches on the east side, from which, a pine 24 in diam bears N19°E 90 lks dist marked T7SR45ES20 B.T. a pine 16 in diam bears N34°W 98 lks dist marked T7SR45ES19 B.T. a pine 6 in diam bears S64°W 32 lks dist marked T7 SR45ES30 B.T. a 16 in diam bears S80°E 25 lks dist marked T7SR45ES29 B.T. (1883 W.Barr GLO Survey)
Subsequent History
A pine, 42 ins. Diam., bears N. 19° E., 86 lks. Dist., with scribe marks 7 4 S visible on open blaze. A pine snag, 24 ins. Dia., bears S. 64° W., 98 lks. Dist., no marks visible. A pine, 33 ins. Diam., bears N 34° W., 98 lks. Dist., with scribe marks 45S visible on opened blaze. Set an iron post, 28 ins. Long, 2 ½ ins. Diam., 24 ins. In the ground, with brass cap mkd. Form which new bearing trees A fir, 21 ins. diam., bears S. 18 ½ ° E., 66 lks. dist., mkd. T7S R45E S29 BT. A fir, 10 ins. Diam., bears S. 32° W., 60 lks. dist., mkd. T7S R45E S30 BT.

SECTION 19			

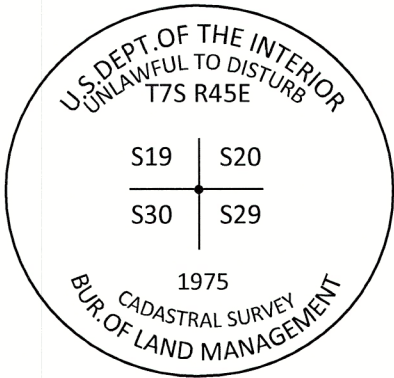

CORNER PERPETUATION
Found Monuments/Accessories
Found 3 ½" brass disk stamped as shown, up 0.6' from wick a 36" diam. Pine tree with open blaze bears N 34° W a distance of 66.0'. A 36" diam. Pine tree with healed blaze bears N 19° E a distance of 55.0'. A 24" Fir tree with healed blaze bears S 18° E a distance of 43.5'.
Established Monuments/Accessories
From said corner bears: An established White Fir tree 24" in diameter, South 34° West 155.2 feet, marked by a 6" spike with 1.5" washer stamped "SWLS INC LS 99516" with a new blaze spraypainted red, scribed T7S R45E S30 BT.



BAKER COUNTY SURVEYOR
Date Received:
Date Filed: October 2, 2024
Filed By:
File Number: 7-45-205



Statewide Land Surveying, Inc.
survey@statewidesurveying.com
www.statewidesurveying.com

43 NW Ava Ave
Gresham, OR 97030
503-665-7777

1915 Washington Ave
Baker City, OR 97814
541-406-3012