

**CERTIFIED RECORD OF LAND CORNER MONUMENTATION**

**HISTORY OF ORIGINAL CORNER ESTABLISHED:**

Corner originally established by N.O. Walden in GLO contract no. 198, dated July 15, 1873. Surveyor General field notes state:

Set granite rock 14x12x6, 8 in. in ground for corner to Secs 35, 36, 1, 2.

Corner monumented by James Hanley by retracement of county road and a long standing fenceline. Survey Number 8-45-01 states:

From Survey No. 7-45-3, filed May 19, 1975, found an ancient fence line running south from the right-of-way fence of Baker County Road No. 729. County Road Book No. 2, Page 36-37, indicates the road centerline was constructed along the section line. Reestablished the corner at the intersection of ancient fence line and centerline of the County Road No. 729 as determined by north and south right-of-way fences.

Set a 2 1/2" brass disc with a 3 1/2" stem, 5/8 diam. flush with the surface of County Road No. 729.

Brass cap found and accepted by Surveys 7-45-45, 7-45-149, 7-25-151, 8-45-61, 8-45-141, and 8-45-143

T 8 S R 45 E A-21

	S	2	

**DESCRIPTION OF CORNER EVIDENCE FOUND:**

None. Adjacent landowners indicate that road has been recently chip sealed by the county, which likely has removed the monument. I make a retracement of surveys that tied this corner and use a least squares method utilizing record measurements to adjacent aliquot corners to place this corner. This position is harmonious with an ancient fenceline to the South and the centerline of Valley View Road.

SEE SURVEY FOR BRANDEN WEIR DATED AUGUST 2022

**DESCRIPTION OF MONUMENT AND ACCESSORIES I ESTABLISHED TO MONUMENT THE ORIGINAL LOCATION OF THIS CORNER:**

At position determined by survey, I set a 5/8" x 30" iron pin, 30" in the ground, with 2" brass cap set flush with the pavement, marked as shown below, from which:


**NEW BEARING OBJECTS:**

A 5/8" x 30" iron pin bears North 53°06 East, a dist. of 23.06 feet, with 1 1/2" aluminum cap marked "BGB Survey Marker NE RP"

A 5/8" x 30" iron pin bears South 63°07' East, a dist. of 33.95 feet, with 1 1/2" aluminum cap marked "BGB Survey Marker SE RP"

A fence corner to an ancient fence bearing South bears South 1° East, a distance of 22.5 feet.

A flagpole bears North 70°40' West, a distance of 65.7 feet.

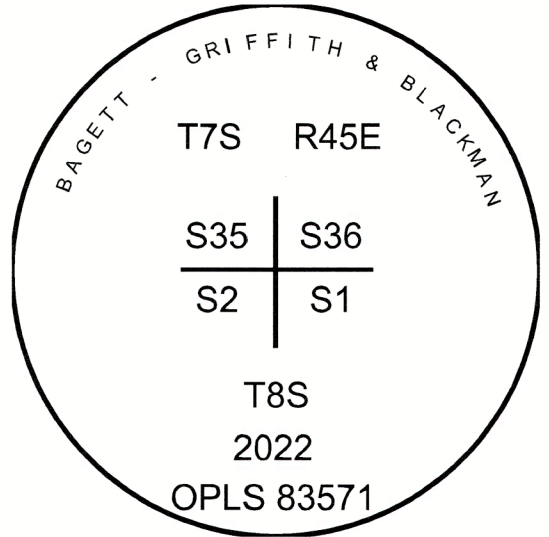

I hereby certify that the corner was monumented on August 3, 2022.

I used a Leica GS18 GPS in the establishment of the new accessories. Basis of bearing is as per Survey for Branden Weir, dated August 2022. Bearings and distances to the iron pins are to the center of the aluminum caps. Bearings and distances to the flagpole and fence corner are to the center.



Renewal Date: June 30, 2023

FILED Aug, 10, 2022  
 BAKER COUNTY SURVEYOR  
 SURVEY NO. 7-45-197  
8-45-154