

CERTIFIED RECORD OF LAND CORNER MONUMENTATION


History of original corner establishment:

Corner established by W. B. Barr under Contract No. 443, dated May 29, 1882.

Surveyor's General record states:

Set volcanic rock 13 ins. x 8 ins. x 6 ins., 9 inches in ground for 1/4 Sec. corner marked 1/4 on the North side, from which

A pine, 9 ins. in diam. bears N. 28° W. 21 lks., dist. marked 1/4 S BT
A pine, 10 ins. in diam. bears S. 12° W. 53 lks., dist. marked 1/4 S BT

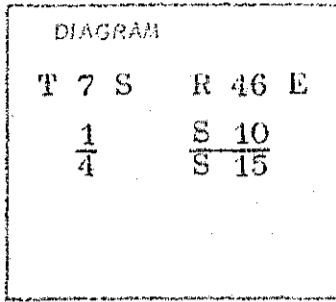

Description of corner evidence found:

Found Section 15 bearing tree with no visible scribe marks.

Description of monument and accessories established to perpetuate the original location of this corner:

Set 2 inch aluminum cap on a 1 inch iron pipe, 28 inches long, 22 inches in ground, marked thus:

T 7 S R 46 E
 $\frac{1}{4}$ $\frac{S 10}{S 15}$
 CS 1974

Office of County Surveyor County of Baker
 State of Oregon, I hereby certify that this within instrument was filed in this office
 for record on the _____ day of _____
 _____ by _____
 (COUNTY OFFICIAL) (DEPUTY)

FILED 7-12-74
 BAKER COUNTY SURVEYOR
 SURVEY NO. 7-46-A

