

CERTIFIED RECORD OF LAND CORNER MONUMENTATION


History of original corner establishment:

Corner established by W. B. Barr under Contract No. 443, dated May 29, 1882.

Surveyor's General record states:

Set volcanic rock 12 ins. x 12 ins. x 6 ins., 8 inches in ground for 1/4 Sec. corner marked 1/4 on the West side, from which

A pine, 15 inches in diam. bears S 57° W 60 lks., dist. marked 1/4 S BT
A pine, 10 inches in diam. bears N 77° E 31 lks., dist. marked 1/4 S BT

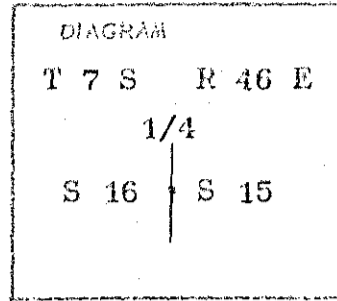


Description of corner evidence found:

Found Section 16 bearing tree with no visible scribe marks.

Description of monument and accessories established to perpetuate the original location of this corner

Set 2 inch aluminum cap on a 1 inch iron pipe, 28 inches long, 22 inches in ground, marked thus:

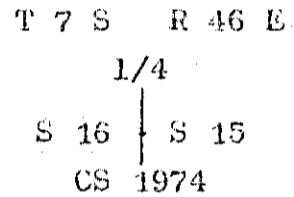

New bearing trees:

A pine, 17 inches in diam. bears N 10° 30' W. 19.5 ft.
A pine, 10 inches in diam. bears S 65° W. 22.5 ft.

Office of.....County Surveyor..... County of..... Baker.....
State of..... Oregon....., I hereby certify that the within instrument was filed in this office
for record on the day of.....
..... by.....
(COUNTY OFFICIAL) (DEPUTY)

FILED 7-12-74
BAKER COUNTY SURVEYOR
SURVEY NO. 7-46-5

