

CERTIFIED RECORD OF LAND CORNER MONUMENTATION


History of original corner establishment:

Corner established by W. B. Barr under Contract No. 443, dated May 29, 1882.

Surveyor's General record states:

Set basalt rock 16 ins. x 14 ins. x 12 ins., 11 inches in ground for 1/4 Sec. corner, marked 1/4 on the West side, from which

A pine 10 ins. diam. bears N. 84° W. 66 lks., dist. marked 1/4 S BT
A pine 32 ins. diam. bears N. 20° E. 24 lks., dist. marked 1/4 S BT

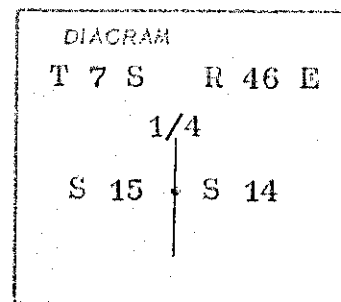


Description of corner evidence found:

Found bearing tree stump.

Description of monument and accessories established to perpetuate the original location of this corner

Set a 2 inch aluminum cap on a 1 inch iron pipe, 28 inches long, 22 inches in the ground, marked thus:

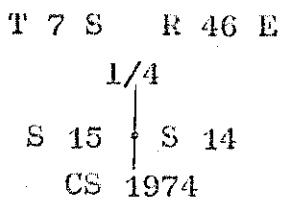

New bearing trees:

A pine 10 ins. in diam. bears S. 21° 30' E. 30.5 ft.
A pine 10 ins. in diam. bears N. 36° 30' W. 23.8 ft.

Office of County Surveyor County of Baker
State of Oregon, I hereby certify that the within instrument was filed in this office
for record on the day of
..... by
(COUNTY OFFICIAL) (DEPUTY)

FILED 7-12-74
BAKER COUNTY SURVEYOR
SURVEY NO. 7-46-6

