

CERTIFIED RECORD OF LAND CORNER MONUMENTATION

History of original corner establishment:

Corner established by W. B. Barr under Contract No. 443, dated May 29, 1882.

Surveyor's General record states:

Set post 4 ft. long, 4 in. diam., 2 ft. in ground for corner to Sec. 16, 17, 20, 21 marked T 7 S S 16 on the NE face, R 46 E S 21 on the SE face, S 20 on the SW face, and S 17 on NW face marked with 3 notches on the South and 4 notches on the East edges, from which


- A pine 22 ins. diam. bears N 13° E 63 lks., dist. marked T 7 S R 46 E S 16 ET
- A pine 44 ins. diam. bears N 63° W 44 lks., dist. marked T 7 S R 46 E S 17 ET
- A pine 7 ins. diam. bears S 66° W 100 lks., dist. marked T 7 S R 46 E S 20 BT
- A pine 7 ins. diam. bears S 78° E 36 lks., dist. marked T 7 S R 46 E S 21 BT

Description of corner evidence found:

Found a pine, 22 ins. diam., bearing N. 13° E., 41.6 ft (63 lks.) dist. with blaze and visible scribe mark "S".

Description of monument and accessories established to perpetuate the original location of this corner

Set 2 inch aluminum cap on a 1 inch iron pipe, 28 inches long, 22 inches in ground, marked thus:

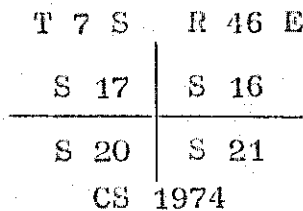

New bearing tree:

A pine, 22 ins. diam. bears S. 81° E. 29.33 ft.

Office of County Surveyor County of Baker
 State of Oregon, I hereby certify that the within instrument was filed in this office
 for record on the _____ day of _____
 _____ by _____
 (COUNTY OFFICIAL) (DEPUTY)

FILED 7-12-74
 BAKER COUNTY SURVEYOR
 SURVEY NO. 7-46-8

