

CERTIFIED RECORD OF LAND CORNER MONUMENTATION


History of original corner establishment:

Corner established by W. B. Barr under Contract No. 443, dated May 29, 1882.

Surveyor's General record states:

Set volcanic rock 22 ins. x 18 ins. x 14 ins. for 1/4 Sec. corner 17 inches in ground marked 1/4 on the North side from which

A pine 9 in. diam. bears N. 41° W. 25 lks., dist. marked 1/4 S BT
A pine 12 in. diam. bears S 24° E. 46 lks., dist. marked 1/4 S BT

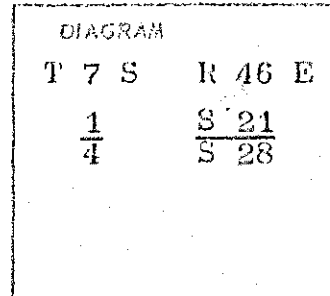

Description of corner evidence found:

Found volcanic rock of record dimensions, Section 21 bearing tree with no visible scribe marks, and Section 28 bearing tree with visible scribe marks.

Description of monument and accessories established to perpetuate the original location of this corner:

Set 2 inch aluminum cap on a 1 inch iron pipe, 28 inches long, 22 inches in ground, marked thus:

T 7 S R 46 E

$\frac{1}{4}$ $\frac{S 21}{S 28}$

CS 1974

Office of County Surveyor County of Baker
State of Oregon, I hereby certify that the within instrument was filed in this office
for record on the day of