

CERTIFIED RECORD OF LAND CORNER MONUMENTATION


History of original corner establishment:

Corner established by W.B. Barr under GLO Contract No. 443 dated May 29, 1882.

Surveyor General's records state:

Set basalt rock 12 X 8 X 7 ins 8 ins in ground for 1/4 Sec corner marked 1/4 on the West side from which:

A pine 28 ins diam bears S 19° W 063 lks dist mkd 1/4 S BT
 A pine 30 ins diam bears N 04° E 115 lks dist mkd 1/4 S BT

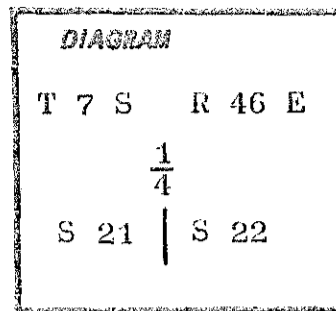

Description of corner evidence found:

- A 30 inch sawed stump uproot bears N 04° E., 75.9 ft. (115 lks) with no visible scribes for Sec 22 BT
- A 24 inch stump bears S 19° W., 41.6 ft (63 lks) with no visible scribes for Sec 21 BT
- A 52 inch sawed stump bears North, 50.2 ft (76 lks) with no visible scribes for official record line tree

At position established from original accessory evidence found a stone 12x8x7 inches firmly set but could not identify any chisle work.

Description of monument and accessories established to perpetuate the original location of this corner:

Set a 2½ inch brass cap on a 2 inch iron pipe 31 ins long 28 ins in the ground with a surrounding rock mound and a 6 ft steel fence post 4 ft North with a sign 54-4 attached. Buried stone alongside brass cap monument.

Brass cap marked thus: T 7 S R 46 E

$\frac{1}{4}$
 S 21 | S 22
 1979
 ORLS 1639

New bearing trees:

- A 10 inch fir bears S 85° W., 17.5 ft dist mkd 1/4 S 21 BT
- A 10 inch fir bears S 05° E., 39.7 ft dist mkd 1/4 S 22 BT

Each old BT and the line tree have a sign 54-3 attached and each new BT has a sign 54-3 attached below a band of red paint and has a brass washer marked LS 1639 nailed flush with BT blaze.

I hereby certify the above corner monument was properly re-established on July 13, 1979 witnessed by Tracy Labaree.

**REGISTERED
 PROFESSIONAL
 LAND SURVEYOR**

William L. Hanley

**OREGON
 JULY 14, 1978
 WILLIAM L. HANLEY
 1639**

Office of..... County of.....
 State of..... I hereby certify that the within instrument was filed in this office
 for record on the..... day of....., 19.....
 by
 (COUNTY OFFICIAL) (DEPUTY)

FILED July 16, 1979
 BAKER COUNTY SURVEYOR
 SURVEY NO. 7-46-14