

CERTIFIED RECORD OF LAND CORNER MONUMENTATION


History of original corner establishment:

Corner established by W.B. Barr under GLO Contract No. 443 dated May 29, 1882.

Surveyor General's records state:

Set basalt rock 13 X 10 X 5 ins 9 ins in ground for 1/4 Sec corner marked 1/4 on the West side from which:

A pine 30 ins diam bears S 18° W 66 lks dist mkd 1/4 S BT  
A pine 36 ins diam bears S 17° E 238 lks dist mkd 1/4 S BT

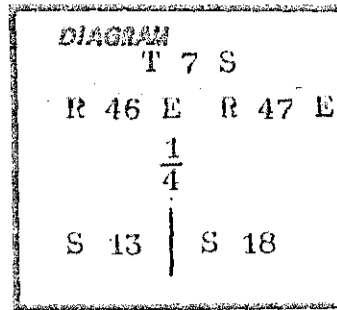

Description of corner evidence found:

Found a basalt stone 13 X 9 X 5 ins lying loose on the ground marked 1/4.  
A 30 inch pine stump sawed at 12 ins bears S 18° W, 43.5 ft ( 66 lks), no visible scribes.  
A 36 inch burned tree bears S 17° E, 157.1 ft (238 lks) no visible scribes.  
A 44 inch stump sawed at 20 ins bears S 59.4 ft (90 lks) for a record line tree.

Description of monument and accessories established to perpetuate the original location of this corner:

Set a 2 1/2 inch brass cap on a 2 inch iron pipe 31 ins long 27 ins in the ground with a 6 ft steel fence post 5 ft north with a sign 54-4 attached. I buried the original stone alongside.

Brass cap marked thus: T 7 S

R 46 E R 47 E

1/4

S 13 | S 18

1979

ORLS 1639

New bearing trees:

A pine 08 ins diam bears N 51° W, 9.9 ft dist mkd 1/4 S 13 BT  
A pine 10 ins diam bears N 30° E 65.7 ft dist mkd 1/4 S 18 BT

Each original BT and the record line tree have a sign 54-3 attached and the new BTs have a sign 54-3 attached below a red band of paint and have a brass washer marked LS 1639 nailed flush with BT blaze.

I hereby certify the above corner monument was properly re-established on July 2, 1979 witnessed by Tracy Labaree and Jim DeMastus.

REGISTERED PROFESSIONAL LAND SURVEYOR

William R Hanley

OREGON JULY 14, 1978 WILLIAM L. HANLEY 1639

Office of..... County of.....  
State of..... I hereby certify that the within instrument was filed in this office  
for record on the..... day of....., 19.....  
..... by .....  
(COUNTY OFFICIAL) (DEPUTY)