


CERTIFIED RECORD OF LAND CORNER MONUMENTATION

History of original corner establishment:

Corner established by W.B. Barr under GLO Contract No. 443 dated May 29, 1882.

Surveyor General's records state:

Set basalt rock 18 X 12 X 12 ins 12 ins in ground for corner to Sec 9, 10, 15, 16 (on ridge course South) Marked with 4 notches on the South and 3 notches on the East edges, from which:

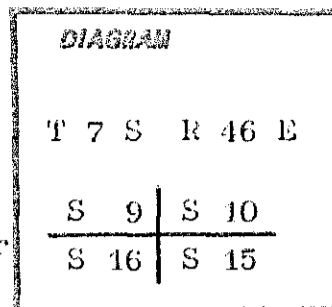

- A pine 13 ins diam bears N 46° E 98 lks dist mkd T 7 S R 46 E S 10 BT
- A pine 08 ins diam bears N 18° W 54 lks dist mkd T 7 S R 46 E S 9 BT
- A pine 04 ins diam bears S 61° W 67 lks dist mkd T 7 S R 46 E S 16 BT
- A pine 30 ins diam bears S 50° E 35 lks dist mkd T 7 S R 46 E S 15 BT

Description of corner evidence found:


Old bearing trees:

- A pine 20 ins bears N 18° W., 54 lks with 46 S scribes visible on opened blaze
 - A pine 46 ins bears S 50° E., 35 lks with 7 S 6 E scribes visible on partially healed blaze
 - A pine 26 ins bears S 61° W., 67 lks with healed blaze
 - A rotten tree bears N 46° E. 98 lks with full scribes on blaze
- Original stone not identified in large mound at corner location

Description of monument and accessories established to perpetuate the original location of this corner:

Set 2½ inch brass cap on a 2 inch iron pipe 31 ins long 20 ins in the ground to solid rock with 6 ft steel fence post alongside with a sign 54-4 and 2 signs 54-2 attached.

Brass cap marked thus: T 7 S R 46 E

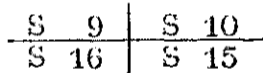

1979
ORLS 1639

New bearing tree:

A pine 9 ins bears N 50° E., 270 ft dist mkd T 7 S R 46 E S 10 BT

Each old bearing tree and the new bearing tree has a sign 54-3 attached below a band of red paint and has a brass washer marked LS 1639 nailed flush with BT blaze.

I hereby certify the above corner monument was properly re-established on July 3, 1979 witnessed by Tracy Labaree and Jim DeMastus.

**REGISTERED
PROFESSIONAL
LAND SURVEYOR**

William L. Hanley

**OREGON
JULY 14, 1978
WILLIAM L. HANLEY
1639**

Office of..... County of.....
 State of....., I hereby certify that the within instrument was filed in this office
 for record on the..... day of....., 19.....
 by
 (COUNTY OFFICIAL) (DEPUTY)

Form R6-7100-57 (9/71)

FILED July 16, 1979
 BAKER COUNTY SURVEYOR
 SURVEY NO. 7-76-18