

CERTIFIED RECORD OF LAND CORNER MONUMENTATION


History of original corner establishment:

Corner established by W.B. Barr under GLO Contract No. 443 dated May 29, 1882.

Surveyor General's records state:

Set basalt rock 18x14x12 ins 12 ins in the ground for 1/4 section corner marked 1/4 on the North side, from which:

A pine 26 ins diam bears N. 70° W., 37 lks dist mkd 1/4 S BT  
A fir 03 ins diam bears S. 67° E., 27 lks dist mkd 1/4 S BT

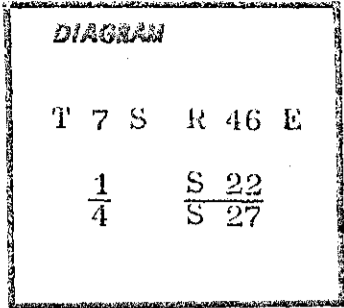

Description of corner evidence found:

None

Description of monument and accessories established to perpetuate the original location of this corner:

Set 2½ inch brass cap on a 2 inch iron pipe 31 ins long 27 ins in the ground with a surrounding rock mound and a 6 ft steel fence post 4 ft North with a sign 54-4 attached.

Brass cap marked thus: T 7 S R 46 E

$\frac{1}{4}$	$\frac{S 22}{S 27}$
1979	
ORLS 1639	

New bearing trees:

A fir 10 ins diam bears N. 58° E., 12.8 ft dist mkd 1/4 S 22 BT  
A fir 08 ins diam bears S. 66° E., 52.5 ft dist mkd 1/4 S 27 BT

Each new BT has a sign 54-3 attached 6 ins below a red band of paint and has a brass washer marked LS 1639 nailed flush with BT blaze.

I hereby certify that the above monument was properly re-established as herein described on July 18, 1979 witnessed by Tracy Labaree and Jim DeMastus.

REGISTERED PROFESSIONAL LAND SURVEYOR

*William L. Hanley*

OREGON JULY 14, 1978 WILLIAM L. HANLEY 1639

Office of..... County of.....  
State of....., I hereby certify that the within instrument was filed in this office for record on the..... day of....., 19.....  
..... by .....  
(COUNTY OFFICIAL) (DEPUTY)

Form R6-7100-51 (9/71)

FILED July 23, 1979  
BAKER COUNTY SURVEYOR  
SURVEY NO. 7-46-20

☆ GPO—798-276