

CERTIFIED RECORD OF LAND CORNER MONUMENTATION


History of original corner establishment:

Corner established by W.B. Barr under GLO Contract No. 443 dated May 29, 1882.

Surveyor General's records state:

Set basalt rock 12x8x8 ins 8 ins in the ground for 1/4 section corner marked 1/4 on the North side, from which:

- A pine 18 ins diam bears S. 59° E., 040 lks dist mkd 1/4 S BT
- A pine 25 ins diam bears N. 47° W., 146 lks dist mkd 1/4 S BT

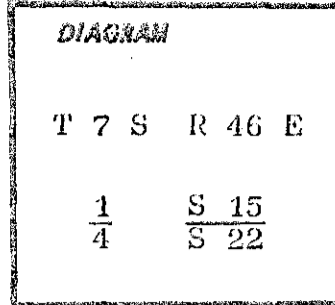

Description of corner evidence found:

None - area has been logged about 20 years ago and older trees show signs of an ancient forest fire.

Description of monument and accessories established to perpetuate the original location of this corner:

Set 2 1/2 inch brass cap on a 2 inch iron pipe 31 ins long 27 ins in the ground with a surrounding rock mound and a 6 ft steel fence post 5 ft East with a sign 54-4 attached.

Brass cap marked thus: T 7 S R 46 E

$\frac{1}{4}$	$\frac{S 15}{S 22}$
---------------	---------------------

1979
ORLS 1639

New bearing trees:

- A pine 08 ins diam bears N. 42° W., 02.7 ft dist mkd 1/4 S 15 BT
- A pine 10 ins diam bears S. 69° E., 37.4 ft dist mkd 1/4 S 22 BT

Each new BT has a sign 54-3 attached 6 ins below a red band of paint and has a brass washer marked LS 1639 nailed flush with BT blaze.

I hereby certify that the above monument was properly re-established as herein described on July 13, 1979 witnessed by Tracy Labaree and Jim DeMastus.

REGISTERED PROFESSIONAL LAND SURVEYOR

William L Hanley

OREGON
JULY 14, 1978
WILLIAM L. HANLEY
1639

Office of..... County of.....
 State of....., I hereby certify that the within instrument was filed in this office
 for record on the..... day of....., 19.....
 by
 (COUNTY OFFICIAL) (DEPUTY)