


CERTIFIED RECORD OF LAND CORNER MONUMENTATION

History of original corner establishment:

Corner established this survey

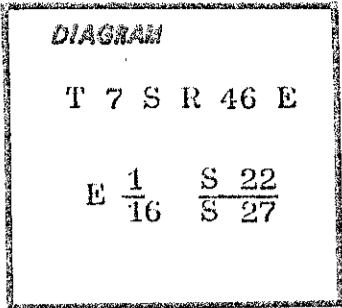

Description of corner evidence found:

A fence corner bears S 71° E, 27.5 ft. dist. from which the fence runs north and west.

Description of monument and accessories established to perpetuate the original location of this corner:

Set a 2½ in. brass cap on a 2 in. iron pipe 31 ins. long 25 ins. in the ground with a surrounding rock mound and a 6 foot steel fence post alongside with a sign 54-9 and a sign 54-2 attached.

Brass cap marked thus: T 7 S R 46 E

E $\frac{1}{16}$ S $\frac{22}{27}$

1979


ORLS 1639

New bearing trees:

A pine 10 ins. diam. bears S 38° W, 51.7 ft. dist. marked E 1/16 S 27 BT.
A pine 10 ins. diam. bears N 69° W, 68.0 ft. dist. marked E 1/16 S 27 BT.

Each new bearing tree has a sign 54-3 attached below a band of red paint and has a brass washer marked LS 1639 nailed flush with BT blaze.

I hereby certify the above corner monument was properly established by me on July 19, 1979 and witnessed by Tracy Labaree and Jim DeMastus.

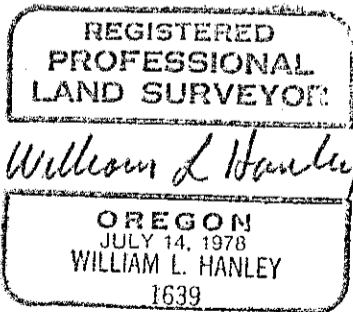

Office of..... County of.....
State of....., I hereby certify that the within instrument was filed in this office
for record on the..... day of....., 19.....

..... by

(COUNTY OFFICIAL)

(DEPUTY)

Form R6-7100-5/ (9/71)

FILED July 23, 1979
BAKER COUNTY SURVEYOR
SURVEY NO. 7-46-22