


CERTIFIED RECORD OF LAND CORNER MONUMENTATION

History of original corner establishment:

Corner established this survey.

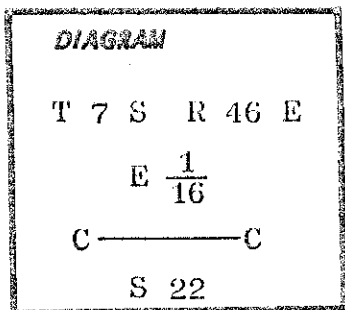


Description of corner evidence found:

A fence corner bears S. 21° W., 31.1 ft dist from which fence runs South and East.

Description of monument and accessories I established to perpetuate the original location of this corner:

Set a 2½ inch brass cap on a 2 inch iron pipe 31 ins long 27 ins in the ground with a surrounding rock mound and a 6 ft steel fence post alongside with 1 sign 54-9 and 2 signs 54-2 attached.

Brass cap marked thus: T 7 S R 46 E

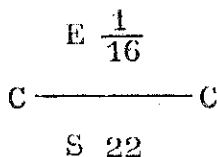

1979  
ORLS 1639

New bearing trees:

A pine 10 ins diam bears N. 52° W., 28.4 ft dist mkd CE 1/16 S 22 BT  
A fir 10 ins diam bears S. 47° W., 43.4 ft dist mkd CE 1/16 S 22 BT

Each new BT has a sign 54-3 attached 6 ins below a band of red paint and has a brass washer marked LS 1639 nailed flush with BT blaze.

I hereby certify the above corner was properly established as herein described on July 19, 1979 witnessed by Tracy Labaree and Jim DeMastus.

**REGISTERED  
PROFESSIONAL  
LAND SURVEYOR**

*William R Hanley*

**OREGON**  
JULY 14 1978  
WILLIAM L. HANLEY  
1639

Office of..... County of.....  
State of....., I hereby certify that the within instrument was filed in this office  
for record on the..... day of....., 19.....

..... by .....  
(COUNTY OFFICIAL) (DEPUTY)

FILED July 23, 1979  
BAKER COUNTY SURVEYOR  
SURVEY NO. 7-46-23