


CERTIFIED RECORD OF LAND CORNER MONUMENTATION

History of original corner establishment:

Corner established this survey.

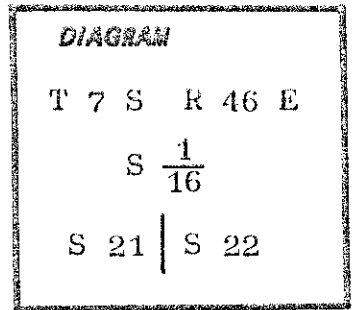


Description of corner evidence found:

None

Description of monument and accessories established to perpetuate the original location of this corner:

Set a 2½ inch brass cap on a 2 inch iron pipe 31 ins long 26 ins in the ground with a surrounding rock mound and a 6 ft steel fence post alongside with a sign 54-9 and 2 signs 54-2 attached.

Brass cap marked thus: T 7 S R 46 E

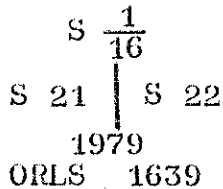

New bearing trees:

A fir 15 ins diam bears N 23° W, 53.5 ft dist mkd S 1/16 S 21 BT
A fir 12 ins diam bears N 12° E, 28.0 ft dist mkd S 1/16 S 22 BT

Each new BT has a sign 54-3 attached below a band of red paint and has a brass washer marked LS 1639 nailed flush with the BT blaze.

I hereby certify that the above monument was properly established as herein described on July 30, 1979 witnessed by Tracy Labaree and Jim DeMastus.

REGISTERED
PROFESSIONAL
LAND SURVEYOR

William L Hanley

OREGON
JULY 14, 1978
WILLIAM L. HANLEY
1639

Office of..... County of.....
State of....., I hereby certify that the within instrument was filed in this office
for record on the..... day of....., 19.....

..... by
(COUNTY OFFICIAL) (DEPUTY)

Form R6-7100-57 (9/71)

FILED Aug. 1, 1979
BAKER COUNTY SURVEYOR
SURVEY NO. 7-46-24