

CERTIFIED RECORD OF LAND CORNER MONUMENTATION


History of original corner establishment:

Corner established by W.B. Barr under GLO Contract No. 443 dated May 29, 1882.

Surveyor General's records state:

Set lava rock 12 X 10 X 8 ins 8 ins in ground for corner to Sec 22, 23, 26, 27 marked with 2 notches on the S and E edges from which:

A pine 18 ins diam bears N 71° E 85 lks dist mkd T 7 S R 46 E S 23 BT  
A pine 11 ins diam bears N 45° W 130 lks dist mkd T 7 S R 46 E S 22 BT  
A pine 26 ins diam bears S 32° W 97 lks dist mkd T 7 S R 46 E S 27 BT  
A pine 15 ins diam bears S 31° E 44 lks dist mkd T 7 S R 46 E S 26 BT

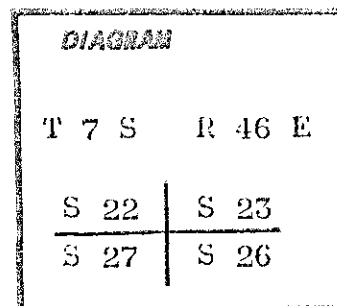

Description of corner evidence found:

A live pine in good condition 36 ins in diam bears N 71° E, 56.1 ft (85 lks) for Sec 23 BT with full scribes on previously opened blaze.

A stone in a mound of stone with identifiable chisle work bears S 71° W, 56.1 ft from the found BT

No trace of the other Bearing Trees

Description of monument and accessories established to perpetuate the original location of this corner:

Set a 2½ inch brass cap on a 2 inch iron pipe 26 ins in the ground with a surrounding rock mound and a 6 ft steel fence post alongside with a sign 54-4 and 2 signs 54-2 attached. Buried the original stone alongside.

Brass cap marked thus: T 7 S R 46 E

S 22	S 23
S 27	S 26

1979  
ORLS 1639

New bearing trees:

A pine 6 ins diam bears S 54° E, 85.9 ft dist mkd T 7 S R 46 E S 26 BT  
A pine 6 ins diam bears S 80° W, 37.0 ft dist mkd T 7 S R 46 E S 27 BT  
A pine 6 ins diam bears N 15° W, 56.2 ft dist mkd T 7 S R 46 E S 22 BT

The original BT has a sign 54-3 attached and each new BT has a sign 54-3 attached below a band of red paint and has a brass washer marked LS 1639 nailed flush with the BT blaze.

I hereby certify that the above monument was properly re-established as herein described on July 2, 1979 witnessed by Tracy Labaree and Jim DeMastus.

REGISTERED  
PROFESSIONAL  
LAND SURVEYOR

*William L. Hanley*

OREGON  
JULY 14, 1978  
WILLIAM L. HANLEY  
1639

Office of..... County of.....

State of..... I hereby certify that the within instrument was filed in this office