

CERTIFIED RECORD OF LAND CORNER MONUMENTATION


History of original corner establishment:

Corner established by W.B. Barr under GLO Contract No. 443 dated May 19, 1882.

Surveyor General's records state:

Set volcanic rock 12x12x6 ins 8 ins in ground for 1/4 Sec corner marked 1/4 on the West side from which:


A pine 13 ins diam bears S 57° W, 60 lks dist mkd 1/4 S BT
A pine 10 ins diam bears N 77° E, 31 lks dist mkd 1/4 S BT

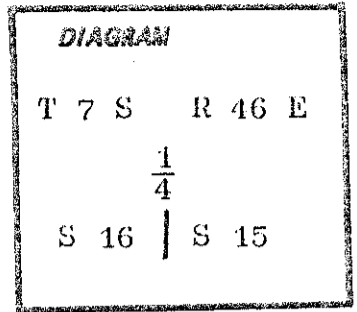

Description of corner evidence found:

A sawed pine stump 24 ins diam for original Sec 15 BT with BT blaze visible.
A pine 22 ins diam with previously open blaze for original Sec 16 BT

Found a 2 1/2 inch aluminum cap on a 1 inch iron pipe in a rock mound marked: T 7 S R 46 E

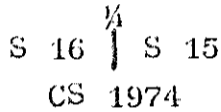

A pine 8 ins diam bears S 61° W, 22.6 ft dist mkd 1/4 S 16 BT scribed by county surveyor in 1974.

Description of monument and accessories established to perpetuate the original location of this corner:

Set a 6 ft steel fence post 4 ft South of aluminum cap monument with a sign 54-2 and a sign 54-4 attached.

A fir 8 ins diam bears N 33° E, 10.0 ft dist mkd 1/4 S 15 BT with a sign 54-3 attached below a band of red paint and has a brass washer marked LS 1639 nailed flush with BT blaze.

Each original BT and the previously scribed BT have a sign 54-3 attached below a band of red paint.

I hereby certify that the above monument was properly re-established as herein described on August 3, 1979 witnessed by Tracy Labaree and Jim DeMastus.

REGISTERED
PROFESSIONAL
LAND SURVEYOR

William L. Hanley

OREGON
JULY 14, 1978
WILLIAM L. HANLEY
1639

Office of..... County of.....
State of....., I hereby certify that the within instrument was filed in this office
for record on the..... day of....., 19.....

..... by

(COUNTY OFFICIAL)

(DEPUTY)

Form R6-7100-57 (9/71)

FILED Aug 9 1979
BAKER COUNTY SURVEYOR
SURVEY NO. 7-46-29