


CERTIFIED RECORD OF LAND CORNER MONUMENTATION

History of original corner establishment:

Corner established by W.B. Barr under GLO Contract No. 443 dated May 29, 1882.

Surveyor General's records state:

Set basalt rock 16x14x11 ins 11 ins in ground for corner to Sec 21, 22, 27, 28 marked with 2 notches on the South and 3 notches on the East edges from which:

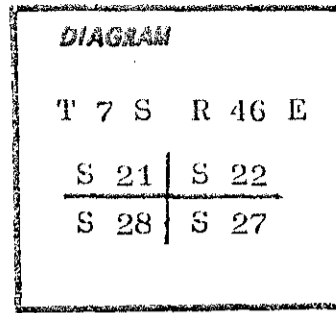

- A pine 09 ins diam bears N 72° E, 187 lks dist mkd T 7 S R 46 E S 22 BT
- A pine 24 ins diam bears N 27° W, 164 lks dist mkd T 7 S R 46 E S 21 BT
- A pine 10 ins diam bears S 59° W, 092 lks dist mkd T 7 S R 46 E S 28 BT
- A pine 20 ins diam bears S 45° E, 088 lks dist mkd T 7 S R 46 E S 27 BT

Description of corner evidence found:

- A pine snag 24 ins diam for Sec 28 BT
- A dead wind blow for Sec 21 BT
- A decomposed stump for Sec 27 BT

Found a 2½ inch brass cap on a 1 inch iron pipe in dirt and rock mound with a lava stone 18x10x4 ins buried alongside.

County Surveyor bearing trees:

- A pine 11 ins diam bears N 77° E, 20.6 ft dist mkd T 7 S R 46 E S 22 BT
- A pine 10 ins diam bears S 66° E, 59.1 ft dist mkd T 7 S R 46 E S 27 BT
- A pine 10 ins diam bears S 25° W, 75.5 ft dist mkd T 7 S R 46 E S 28 BT
- A pine 13 ins diam bears N 40° W, 40.5 ft dist mkd T 7 S R 46 E S 21 BT

Description of monument and accessories I established to perpetuate the original location of this corner:

Set a 6 ft steel fence post 4 ft North of corner monument with signs 54-4 54-2 attached.

Each bearing tree established by County Surveyor has a sign 54-3 attached below a band of red paint and has a brass washer marked LS 1639 nailed flush with BT blaze.



I hereby certify the above work done to perpetuate this corner was done by me on July 30, 1979 witnessed by Tracy Labaree and Jim DeNastus.

Office of..... County of.....  
 State of....., I hereby certify that the within instrument was filed in this office  
 for record on the..... day of....., 19.....  
 ..... by .....  
 (COUNTY OFFICIAL) (DEPUTY)

FILED Aug. 9, 1979  
 BAKER COUNTY SURVEYOR  
 SURVEY NO. 7-46-34