


CERTIFIED RECORD OF LAND CORNER MONUMENTATION

History of original corner establishment:

Corner established by W.B. Barr under GLO Contract No. 443 dated May 29, 1882.

Surveyor General's records state:

Set a basalt rock 16x12x11 ins 11 ins in the ground for 1/4 Sec Cor marked 1/4 on the West side and dug pits 18x18x12 ins 5 1/2 ft dist N. & S. of stone and raised mound of earth 1 1/2 ft high 3 1/2 ft base alongside.

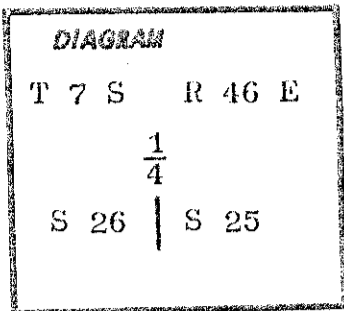


Description of corner evidence found:

Found a basalt stone 18x9x8 ins in a mound of 3 stones and a 1/2x24 inch rebar alongside. A fence bears East 2 ft dist and runs North and South.

Description of monument and accessories established to perpetuate the original location of this corner:

Set a 2 1/2 inch brass cap on a 2 inch iron pipe 31 ins long 28 ins in the ground with a surrounding rock mound and a 6 ft steel fence post 4 ft South with a sign 54-4 attached. Buried stone alongside corner monument.

Brass cap marked thus: T 7 S R 46 E

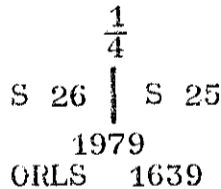

New bearing trees:

A pine 6 ins diam bears S 25° W, 175.0 ft dist mkd 1/4 S 26 BT
A pine 12 ins diam bears S 09° E, 222.1 ft dist mkd 1/4 S 25 BT

Each new BT has a sign 54-3 attached below a band of red paint and has a brass washer marked LS 1639 nailed flush with BT blaze.

I hereby certify that the above monument was properly re-established as herein described on August 8, 1979 witnessed by Tracy Labaree and Jim DeMastus.

REGISTERED
PROFESSIONAL
LAND SURVEYOR

William L. Hanley

OREGON
JULY 14, 1978
WILLIAM L. HANLEY

Office of..... County of.....
State of....., I hereby certify that the within instrument was filed in this office
for record on the..... day of....., 19.....
..... by
(COUNTY OFFICIAL) (DEPUTY)

Form R6-7100-5/ (9/71)

FILED Aug. 9, 1979
BAKER COUNTY SURVEYOR
SURVEY NO. 7-46-35