


CERTIFIED RECORD OF LAND CORNER MONUMENTATION

History of original corner establishment:

Corner established this survey.

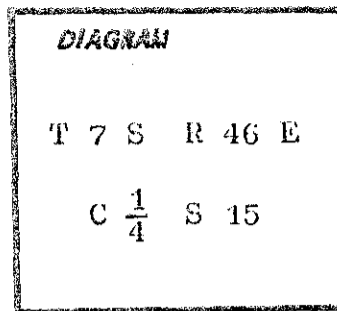

Description of corner evidence found:

None

Description of monument and accessories established to perpetuate the original location of this corner:

Set a 2½ inch brass cap on a 2 inch iron pipe 31 ins long 27 ins in the ground with a surrounding rock mound and a 6 foot steel fence post alongside with a sign 54-9 and 2 signs 54-2 attached.

Brass cap marked thus: T 7 S R 46 E
C $\frac{1}{4}$ S 15
1979
ORLS 1639

New bearing trees:

A fir 6 ins diam bears N 42° W., 11.4 ft dist marked C1/4S15 BT
A fir 8 ins diam bears N 57° E., 29.8 ft dist marked C1/4S15 BT

Each new bearing tree has a sign 54-3 attached below a band of red paint and has a brass washer marked LS 1639 nailed flush with BT blaze.

I hereby that the above corner monument was properly established on August 13, 1979 and witnessed by Tracy Labaree.

REGISTERED
PROFESSIONAL
LAND SURVEYOR

William L Hanley

OREGON
JULY 14, 1978
WILLIAM L. HANLEY
1639

Office of...County Surveyor..... County of...Baker.....
State of...Oregon..... I hereby certify that the within instrument was filed in this office
for record on the..... day of....., 19.....
..... by
(COUNTY OFFICIAL) (DEPUTY)

Form R6-7100-51 (9/71)

FILED Aug. 16, 1979
BAKER COUNTY SURVEYOR
SURVEY NO. 7-46-36