

CERTIFIED RECORD OF LAND CORNER MONUMENTATION


History of original corner establishment:

Corner established by W.B. Barr under GLO Contract No. 443 dated May 29, 1882.

Surveyor General's records state:

Set basalt rock 11 X 10 X 6 ins 7 ins in ground for 1/4 Sec corner marked 1/4 on the West side from which:


A pine 30 ins diam bears S 55° E 56 lks dist mkd 1/4 S BT
 A pine 30 ins diam bears S 40° W 10 lks dist mkd 1/4 S BT

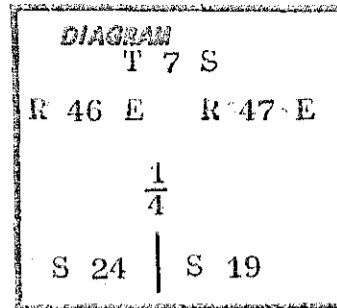

Description of corner evidence found:

A sawed stump with BT scribes visible for Section 19 bearing tree
 A sawed stump with BT scribes visible for Section 24 bearing tree

At record position found a stone 11 x 10 x 6 ins marked 1/4 alongside a 2 1/2 inch aluminum cap on a 1 inch iron pipe marked

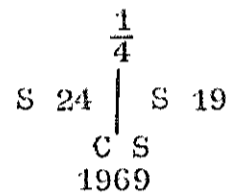

Description of monument and accessories established to perpetuate the original location of this corner:

Set a 6 foot steel fence post 3 feet North of corner monument, improved surrounding rock mound, and buried original stone alongside aluminum cap monument.
 The fence post has a sign 54-2 and 54-4 attached.

New bearing trees:

A fir 10 ins diam bears N 77° W., 27.3 ft dist marked 1/4 S 24 BT
 A pine 8 ins diam bears N 62° E., 21.5 ft dist marked 1/4 S 19 BT

Each original BT stump has a sign 54-3 attached and each new bearing tree has a sign 54-3 attached below a band of red paint and has a brass washer marked LS 1639 nailed flush with BT blaze.

I hereby certify the above corner monument was properly perpetuated on August 13, 1979, and witnessed by Tracy Labaree.

Office of County Surveyor County of Baker
 State of Oregon, I hereby certify that the within instrument was filed in this office
 for record on the..... day of....., 19.....
 by
 (COUNTY OFFICIAL) (DEPUTY)

Form R6-7100-57 (9/71)

FILED Aug. 16, 1979
 BAKER COUNTY SURVEYOR
 SURVEY NO. 7-46-37