


CERTIFIED RECORD OF LAND CORNER MONUMENTATION

History of original corner establishment:

Corner established this survey.

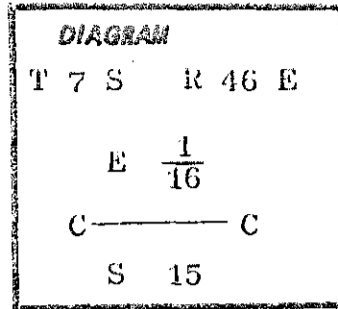

Description of corner evidence found:

None

Description of monument and accessories established to perpetuate the original location of this corner:

Set a 2½ inch brass cap on a 2 inch iron pipe 31 ins long 8 ins below the road surface with a 6 foot steel fence post 4 feet South with a sign 54-2 and 54-9 attached and a 4" x 4" x 6 foot treated wood post 25.8 feet west with a sign 54-2 and 54-5 attached.

Brass cap marked thus:    T 7 S R 46 E  
                                   E  $\frac{1}{16}$   
                                   C ————— C  
                                   S 15  
                                   1979  
                                   ORLS 1639

New bearing trees:

A pine 8 ins diam bears N 14° E., 70.0 ft dist marked CE 1/16 S 15 BT  
A pine 6 ins diam bears West, 31.1 ft dist marked CE 1/16 S 15 BT

Each new bearing tree has a sign 54-3 attached below a band of red paint and has a brass washer marked LS 1639 nailed flush with BT blaze.

I hereby certify that the above corner monument was properly established by me on August 13, 1979 and witnessed by Tracy Labaree.

REGISTERED  
PROFESSIONAL  
LAND SURVEYOR

*William L Hanley*

OREGON  
JULY 14, 1978  
WILLIAM L. HANLEY  
1639

Office of... County Surveyor..... County of... Baker  
State of... Oregon..... I hereby certify that the within instrument was filed in this office 1639  
for record on the..... day of....., 19.....

..... by .....  
(COUNTY OFFICIAL) (DEPUTY)

Form R6-7100-51 (9/71)

FILED Aug. 16, 1979  
BAKER COUNTY SURVEYOR  
SURVEY NO. 7-46-39