

CERTIFIED RECORD OF LAND CORNER MONUMENTATION


History of original corner establishment:

Corner established by W.B. Barr under GLO Contract No. 443 dated May 29, 1882.

Surveyor General's records state:

Set post 4 ft long 4 ins diam 24 ins in ground for 1/4 Sec corner marked 1/4 S on the West side from which:

A pine 18 ins diam bears S 60° W 8 lks dist mkd 1/4 S BT  
A pine 8 ins diam bears N 28° E 58 lks dist mkd 1/4 S BT

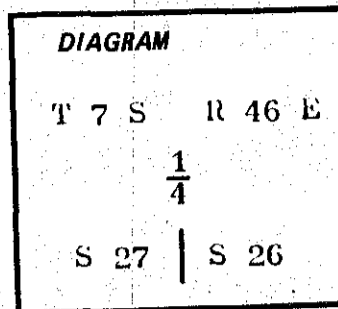

Description of corner evidence found:

A fence corner bears east, 19.3 ft. from which fence runs north, south and west.

Description of monument and accessories established to perpetuate the original location of this corner:

Set a 2 1/2 in. brass cap on a 2 inch iron pipe 31 ins. long 26 ins. in the ground with a surrounding rock mound and a 6 ft. steel fence post alongside with a sign 54-4 and 2 signs 54-3 attached.

Brass cap marked thus:      T 7 S      R 46 E

1/4

S 27 | S 26

1979

ORLS 1639

New bearing trees:

A 6 inch fir bears S 74° E., 6.2 ft. dist. mkd. 1/4 S 26 BT  
A 6 inch pine bears N 28° W., 50.9 ft. dist. mkd. 1/4 S 27 BT

Each new bearing tree has a sign 54-3 attached below a red band of paint and has a brass washer marked LS 1639 nailed flush with top blaze.

I hereby certify the above corner monument was properly re-established by me on August 24, 1979; and witnessed by Brad Gordon and Tom Fisk.

Office of..... County of.....  
 State of....., I hereby certify that the within instrument was filed in this office  
 for record on the..... day of....., 19.....  
 ..... by .....  
 (COUNTY OFFICIAL) (DEPUTY)

**REGISTERED  
PROFESSIONAL  
LAND SURVEYOR**

*William L Hanley*

**OREGON**  
JULY 14, 1978  
WILLIAM L. HANLEY  
1639

Form R6-7100-57 (9/71)

FILED Sept. 15, 1979  
 BAKER COUNTY SURVEYOR  
 SURVEY NO. 7-46-42

☆ GPO 799-509