


CERTIFIED RECORD OF LAND CORNER MONUMENTATION

History of original corner establishment:

Corner established this survey.

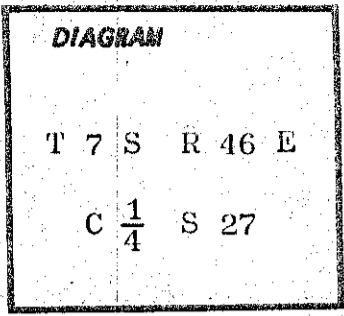

Description of corner evidence found:

A fence line bears south, 89.6 ft. dist. from which the fence runs east and west.

Description of monument and accessories I established to perpetuate the original location of this corner:

Set a 2½ in. brass cap on a 2 in. iron pipe 31 ins. long 26 ins. in the ground with a surrounding rock mound and a 6 ft. steel fence post 3 feet east with a sign 54-9 and a sign 54-2 attached.

Brass cap marked thus: T 7 S R 46 E
C $\frac{1}{4}$ S 27
1979
ORLS 1639

New bearing trees:

A 8 inch pine bears N 49° E., 19.7 ft dist. mkd. C $\frac{1}{4}$ S 27 BT
A 8 inch pine bears N 63° W., 49.3 ft. dist. mkd. C $\frac{1}{4}$ S 27 BT

Each new bearing tree has a sign 54-3 attached below a band of red paint and has a brass washer marked LS 1639 nailed flush with BT blaze.

I hereby certify the above corner monument was properly reestablished by me on Sept. 11, 1979 and witnessed by Jeff Townsend.

REGISTERED
PROFESSIONAL
LAND SURVEYOR

William L Hanley

OREGON
JULY 14, 1978
WILLIAM L. HANLEY
1639

Office of..... County of.....
State of....., I hereby certify that the within instrument was filed in this office
for record on the..... day of....., 19.....

..... by
(COUNTY OFFICIAL) (DEPUTY)

Form R6-7100-51 (9/71)

FILED Sept. 15, 1979
BAKER COUNTY SURVEYOR
SURVEY NO. 7-46-43