


CERTIFIED RECORD OF LAND CORNER MONUMENTATION

History of original corner establishment:

Corner established this survey.

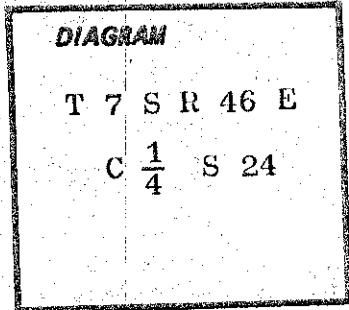

Description of corner evidence found:

None

Description of monument and accessories established to perpetuate the original location of this corner:

Set a 2½ in. brass cap on a 2 in. iron pipe 31 ins. long 25 ins. in the ground with a surrounding rock mound and a 6 foot steel fence post 2 feet north with a sign 54-9 and a sign 54-2 attached.

Brass cap marked thus:

T 7 S R 46 E
 C $\frac{1}{4}$ S 24
 1979
 ORLS 1639

New bearing trees:

A pine 12 ins. diam. bears S 12° E., 148.8 ft. dist. marked C 1/4 S 24 BT
 A pine 19 ins. diam. bears S 06° W., 196.0 ft. dist. marked C 1/4 S 24 BT

Each new bearing tree has a sign 54-3 attached below a band of red paint and has a brass washer marked LS 1639 nailed flush with BT blaze.

I hereby certify the above corner monument was properly established by me on Sept. 14, 1979 and witnessed by Tom Fisk and Jeff Townsend.

**REGISTERED
 PROFESSIONAL
 LAND SURVEYOR**

William L. Hanley

OREGON
 JULY 14, 1978
 WILLIAM L. HANLEY
 1639

Office of..... County of.....
 State of....., I hereby certify that the within instrument was filed in this office
 for record on the..... day of....., 19.....

..... by (DEPUTY)
 (COUNTY OFFICIAL)

Form R6-7100-51 (9/71)

FILED Sept. 15, 1979
 BAKER COUNTY SURVEYOR
 SURVEY NO. 7-46-44