


CERTIFIED RECORD OF LAND CORNER MONUMENTATION

History of original corner establishment:

Corner established this survey.

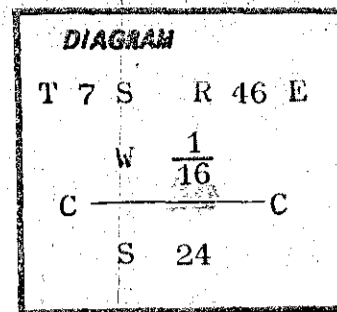


Description of corner evidence found:

None.

Description of monument and accessories I established to perpetuate the original location of this corner:

Set a 2½ in. brass cap on a 2 in. iron pipe 31 ins. long 15 ins. in the ground to solid rock with a surrounding rock mound and a 6 ft. steel fence post alongside with a sign 54-9 and 2 signs 54-2 attached.

Brass cap marked thus: T 7 S R 46 E

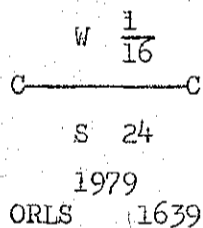

New bearing trees:

A pine, 12 inch diam. bears N 82° W., 32.5 ft. dist. mkd. CW 1/16 S 24 BT
A pine, 6 inch diam. bears N 73° E., 66.2 ft. dist. mkd. CW 1/16 S 24 BT

Each new bearing tree has a sign 54-3 attached below a band of red paint and has a brass washer marked LS 1639 nailed flush with BT blaze.

I hereby certify the above corner monument was properly established by me on Sept. 13, 1979 and witnessed by Tom Fisk and Jeff Townsend.

REGISTERED PROFESSIONAL LAND SURVEYOR

OREGON JULY 14, 1978 WILLIAM L. HANLEY

Office of..... County of..... 1639

State of....., I hereby certify that the within instrument was filed in this office for record on the..... day of....., 19.....

..... by (COUNTY OFFICIAL) (DEPUTY)

Form R6-7100-51 (9/71)

FILED Sept. 20, 1979
BAKER COUNTY SURVEYOR
SURVEY NO. 7-46-47