


CERTIFIED RECORD OF LAND CORNER MONUMENTATION

History of original corner establishment:

Corner established this survey.

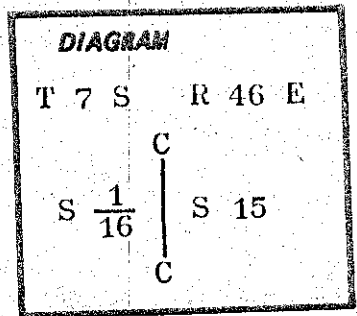


Description of corner evidence found:

None.

Description of monument and accessories established to perpetuate the original location of this corner:

Set a 2½ in. brass cap on a 2 in. iron pipe 31 ins. long 27 ins. in the ground with a surrounding rock mound and a 6 ft. fence post alongside with a sign 54-9 and a sign 54-2 attached.

Brass cap marked thus: T 7 S R 46 E

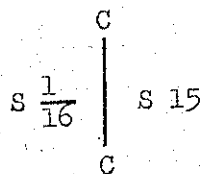

1979  
ORLS      1639

New bearing trees:

A pine, 8 in. diam. bears S 20° W., 57.5 ft. dist. mkd. CS 1/16 S 15 BT  
 A fir, 12 in. diam. bears S 80° E., 34.0 ft. dist. mkd. CS 1/16 S 15 BT

Each new bearing tree has a sign 54-3 attached below a band of red paint and has a brass washer marked IS 1639 nailed flush with BT blaze.

I hereby certify the above corner monument was properly established by me on August 24, 1979 and witnessed by Brad Gordon and Jim DeMastus.

**REGISTERED  
PROFESSIONAL  
LAND SURVEYOR**

*William L. Hanley*

**OREGON**  
JULY 14, 1978  
WILLIAM L. HANLEY

Office of..... County of.....  
 State of....., I hereby certify that the within instrument was filed in this office  
 for record on the..... day of....., 19.....

..... by .....  
 (COUNTY OFFICIAL) (DEPUTY)

Form R6-7100-51 (9/71)

FILED Sept 20, 1979  
 BAKER COUNTY SURVEYOR  
 SURVEY NO. 7-46-48