


CERTIFIED RECORD OF LAND CORNER MONUMENTATION

History of original corner establishment:

Corner established this survey.

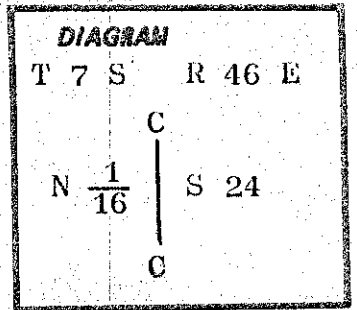


Description of corner evidence found:

None.

Description of monument and accessories I established to perpetuate the original location of this corner:

Set a 2 1/2 in. brass cap on a 2 in. iron pipe 31 ins. long 28 ins. in the ground with a surrounding rock mound and a 6 ft. steel fence post alongside with a sign 54-9 and 2 signs 54-2 attached.

Brass cap marked thus: T 7 S R 46 E

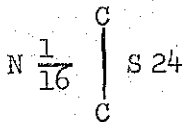

1979  
ORLS 1639

New bearing trees:

A pine 10 ins. diam. bears N 45° E., 5.4 ft. dist. mkd. CN 1/16 S 24 BT  
A pine 8 ins. diam. bears N 11° W., 42.1 ft. dist. mkd. CN 1/16 S 24 BT

Each new bearing tree has sign, 54-3, attached below a band of red paint and has a brass washer marked LS 1639 nailed flush with BT blaze.

I hereby certify the above corner monument was established properly by me on Sept. 13, 1979 and witnessed by Tom Fisk and Jeff Townsend.

**REGISTERED  
PROFESSIONAL  
LAND SURVEYOR**

*William L. Hanley*

**OREGON  
JULY 14, 1978  
WILLIAM L. HANLEY  
1639**

Office of..... County of.....

State of....., I hereby certify that the within instrument was filed in this office for record on the..... day of....., 19.....

..... by .....

(COUNTY OFFICIAL)

(DEPUTY)

Form R6-7100-5/ (9/71)

FILED Sept. 20, 1979  
BAKER COUNTY SURVEYOR  
SURVEY NO. 7-46-49