


CERTIFIED RECORD OF LAND CORNER MONUMENTATION

History of original corner establishment:

Corner established this survey.

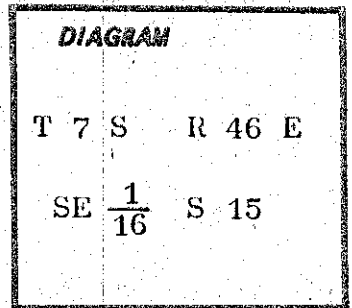

Description of corner evidence found:

Found a 1 in. X 2 in. X 18 in. wooden stake painted yellow for corner point.

Description of monument and accessories I established to perpetuate the original location of this corner:

Set a 2 1/2 in. brass cap on a 2 in. iron pipe 31 ins. long 27 ins. in the ground with a surrounding rock mound and a 6 ft. steel fence post alongside with a sign 54-9 and 2 signs 54-2 attached.

Brass Cap marked thus: T 7 S R 46 E

SE  $\frac{1}{16}$  S 15

ORLS<sup>1979</sup> 1639

New bearing trees:

A pine, 8 in. diam. bears N 43° E., 40.3 ft. dist. mkd. SE 1/16 S 15 BT  
A pine, 14 in. diam. bears S 70° E., 22.4 ft. dist. mkd. SE 1/16 S 15 BT

Each new bearing tree has a sign 54-3 attached below a band of red paint and has a brass washer marked LS 1639 nailed flush with BT blaze.

I hereby certify the above corner monument was properly established by me on Aug. 20, 1979 and witnessed by Tracy Labaree.

REGISTERED  
PROFESSIONAL  
LAND SURVEYOR

*William L. Hanley*

OREGON  
JULY 14, 1978  
WILLIAM L. HANLEY  
1639

Office of..... County of.....  
State of....., I hereby certify that the within instrument was filed in this office  
for record on the..... day of....., 19.....

..... by .....  
(COUNTY OFFICIAL) (DEPUTY)

Form R6-7100-51 (9/71)

FILED Sept. 20, 1979  
BAKER COUNTY SURVEYOR  
SURVEY NO. 7-46-50