


CERTIFIED RECORD OF LAND CORNER MONUMENTATION

History of original corner establishment:

Corner established by W.B. Barr under GLO Contract No. 443 dated May 29, 1882.

Surveyor General's records state:

Set basalt rock 15 X 11 X 10 ins 10 ins in ground for corner to Sec 13, 18, 19, 24 marked with 3 notches on the North and South edges, dug pits 18 X 16 X 12 ins in each section 5½ ft dist and raised mound of earth 2 ft high 4½ ft base alongside.

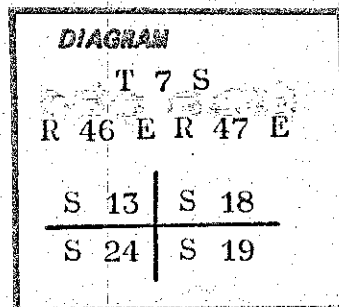

Description of corner evidence found:

None.

Description of monument and accessories established to perpetuate the original location of this corner:

Set a 2½ in. brass cap on a 2 in. iron pipe 31 ins. long 26 ins. in the ground with a surrounding rock mound and a 6 ft. fence post alongside (3' south) with a sign 54-4 attached.

Brass cap marked thus:

T 7 S
R 46 E R 47 E

S 13 S 18
S 24 S 19

ORLS¹⁹⁷⁹1639

New bearing trees:

A pine 12 in. diam. bears N 33 E., 52.5 ft. dist. mkd. T 7 S R 47 E S 18 BT
A pine 8 in. diam. bears S 40 E., 68.8 ft. dist. mkd. T 7 S R 47 E S 19 BT
A pine 8 in. diam. bears S 01 W., 61.5 ft. dist. mkd. T 7 S R 46 E S 24 BT
A pine 8 in. diam. bears N 15 W., 9.80 ft. dist. mkd. T 7 S R 46 E S 13 BT

Each new bearing tree has a sign 54-3 attached below a band of red paint and has a brass washer marked LS 1639 nailed flush with BT blaze.

I hereby certify the above corner monument was properly re-established by me on Aug. 20, 1979 and witnessed by Tracy Labaree.

**REGISTERED
PROFESSIONAL
LAND SURVEYOR**

William L. Hanley

**OREGON
JULY 14, 1978
WILLIAM L. HANLEY**

Office of..... County of.....
State of....., I hereby certify that the within instrument was filed in this office for record on the..... day of....., 19.....

..... by
(COUNTY OFFICIAL) (DEPUTY)

Form R6-7100-57 (9/71)

FILED Sept. 20, 1979

BAKER COUNTY SURVEYOR

SURVEY NO. 7-46-51