


CERTIFIED RECORD OF LAND CORNER MONUMENTATION

History of original corner establishment:

Corner established this survey.

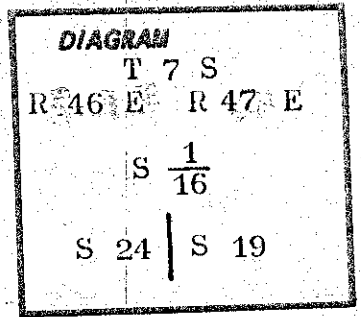


Description of corner evidence found:

None

Description of monument and accessories I established to perpetuate the original location of this corner:

Set a 2½ in. brass cap on a 2 in. iron pipe 31 ins. long 26 ins. in the ground with a surrounding rock mound and a 6 foot steel fence post alongside with a sign 54-9 and 2 signs 54-2 attached.

Brass cap marked thus:

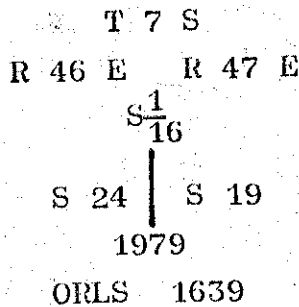

New bearing trees:

A pine 18 ins. diam. bears N 69° W., 184.1 ft. dist. marked S 1/16 S 24 BT  
A pine 22 ins. diam. bears N 87° E., 9.0 ft. dist. marked S 1/16 S 19 BT

Each new bearing tree has a sign 54-3 attached below a band of red paint and has a brass washer marked LS 1639 nailed flush with BT blaze.

I hereby certify the above corner monument was properly established by me on Sept. 14, 1979 and witnessed by Tom Fisk and Jeff Townsend.

REGISTERED PROFESSIONAL LAND SURVEYOR
---

*William L. Hanley*

OREGON JULY 14, 1978 WILLIAM L. HANLEY 1639
--

Office of..... County of.....  
 State of..... I hereby certify that the within instrument was filed in this office  
 for record on the..... day of....., 19.....  
 ..... by .....  
 (COUNTY OFFICIAL) (DEPUTY)

Form R6-7100-51 (9/71)

FILED Sept, 21, 1979  
 BAKER COUNTY SURVEYOR  
 SURVEY NO. 7-46-53