


CERTIFIED RECORD OF LAND CORNER MONUMENTATION

History of original corner establishment:

Corner established this survey:

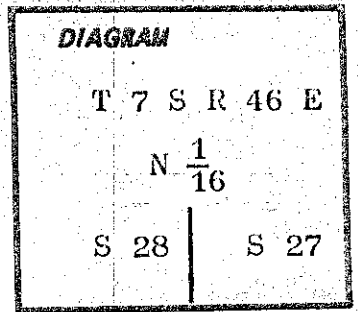


Description of corner evidence found:

None

Description of monument and accessories I established to perpetuate the original location of this corner:

Set a 2½ in. brass cap on a 2 in. iron pipe 31 ins. long 25 ins. in the ground with a surrounding rock mound and a 6 foot steel fence post 2 feet north with a sign 54-9 and a sign 54-2 attached.

Brass cap marked thus: T 7 S R 46 E

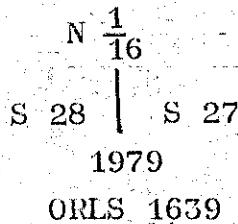

New bearing trees:

A pine 12 ins. diam. bears S 74° E, 40.3 ft. dist. marked N 1/16 S 27 BT
A larch 11 ins. diam. bears S 34° W, 41.0 ft. dist. marked N 1/16 S 28 BT

Each new bearing tree has a sign 54-3 attached below a band of red paint and has a brass washer marked LS 1639 nailed flush with BT blaze.

I hereby certify the above corner monument was properly established by me on Sept. 11, 1979 and witnessed by Jeff Townsend.

REGISTERED PROFESSIONAL LAND SURVEYOR
--

William L Hanley

OREGON JULY 14, 1978 WILLIAM L. HANLEY 1639

Office of..... County of.....
State of....., I hereby certify that the within instrument was filed in this office
for record on the..... day of....., 19.....

..... by
(COUNTY OFFICIAL) (DEPUTY)

Form R6-7100-5/ (9/71)

FILED Sept. 21, 1979
BAKER COUNTY SURVEYOR
SURVEY NO. 7-46-55