


CERTIFIED RECORD OF LAND CORNER MONUMENTATION

History of original corner establishment:

Corner established this survey.

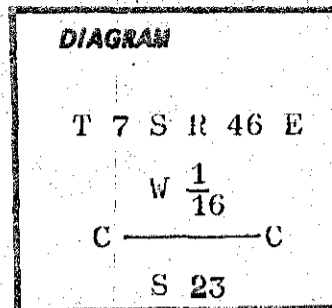


Description of corner evidence found:

A fence corner bears S 40° W, 86.2 ft. dist. from which the fence runs south and east.

Description of monument and accessories established to perpetuate the original location of this corner:

Corner point is on a large boulder. I therefore chisled an X at the corner point and set a 6 foot steel fence post alongside with 2 signs 54-2 attached and set two 2½ in. brass caps on 2 in. iron pipes 31 ins long 25 ins. in the ground for reference monuments, each with a 6 foot steel fence post alongside with a sign 54-9 and a sign 54-2 attached.

Reference monuments marked thus:

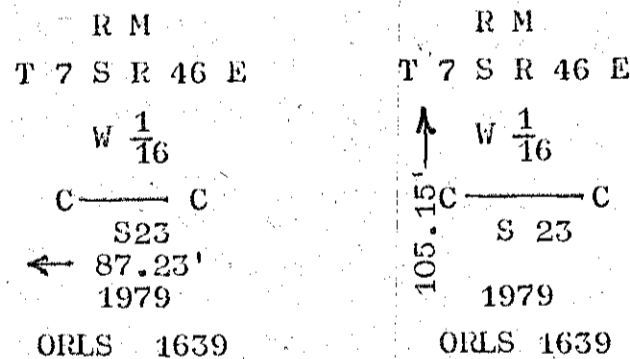

New bearing trees:

A pine 12 ins. diam. bears S 60° W, 115.2 ft. dist. marked CW 1/16 S 23 BT
 A pine 20 ins. diam. bears N 30° E, 143.2 ft. dist. marked CW 1/16 S 23 BT

Each new bearing tree has a sign 54-3 attached below a band of red paint and has a brass washer marked LS 1639 nailed flush with BT blaze.

I hereby certify the above corner monument was properly established by me on Sept. 12, 1979 and witnessed by Tom Fisk and Jeff Townsend.

Office of..... County of.....
 State of..... I hereby certify that the within instrument was filed in this office
 for record on the..... day of....., 19.....
 by
 (COUNTY OFFICIAL) (DEPUTY)

REGISTERED PROFESSIONAL LAND SURVEYOR <i>William L Hanley</i> OREGON JULY 14, 1978 WILLIAM L. HANLEY 1639
--

Form R6-7100-51 (9/71)

FILED Sept. 25, 1979
 BAKER COUNTY SURVEYOR
 SURVEY NO. 7-46-58