


CERTIFIED RECORD OF LAND CORNER MONUMENTATION

History of original corner establishment:

Corner established by W. B. Barr under GLO contract No. 443 dated May 29, 1882.

Surveyor's General records state:

Set a basalt rock 13 x 12 x 10 ins. 9 ins. in the ground for corner to secs 23, 24, 25 and 26 marked with 2 notches on the South and 1 notch on the East edges and raised mound of rock alongside; pits impractical.

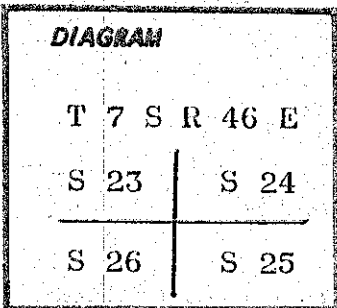

Description of corner evidence found:

An ancient fence intersection (fence runs east, west and south) with a stone of record dimensions in a large surrounding rock jack. No distinguishable marks found on stone.

Note: At 79.0 chains Barr intersected the bottom of a canyon and he set the corner at 80.0 chains. This fence intersection is exactly 1.0 chains from the bottom of the canyon and in line with the south running fence line in which the quarter section corner stone to the south was found.

Description of monument and accessories I established to perpetuate the original location of this corner:

Set a 2½ in. brass cap on a 2 in. iron pipe 31 ins. long 18 ins. in the ground to solid rock underneath a tripod shaped rock jack with a surrounding rock mound and a 6 foot steel fence post alongside with a sign 54-4 and 2 signs 54-2 attached.

Brass cap marked thus:

T 7	S R	46	E
S 23		S 24	
S 26		S 25	

1979

ORLS 1639

New bearing trees:

- A pine 8 ins. diam. bears N 33° E, 187.6 ft dist marked T 7 S R 46 E S24 BT
- A pine 18 ins. diam. bears S 21° E, 132.9 ft dist marked T 7 S R 46 E S25 BT
- A pine 24 ins. diam. bears S 63° W, 119.1 ft dist marked T 7 S R 46 E S26 BT
- A pine 6 ins. diam. bears N 75° W, 188.1 ft dist marked T 7 S R 46 E S23 BT

Each new bearing tree has a sign 54-3 attached below a band of red paint and has a brass washer marked LS 1639 nailed flush with BT blaze.

I hereby certify the above corner monument was properly re-established by me on August 17, 1979 and witnessed by Tracy Labaree and Jim DeMastus.

**REGISTERED
PROFESSIONAL
LAND SURVEYOR**

William L. Hanley

OREGON
JULY 14, 1978
WILLIAM L. HANLEY
1639

Office of..... County of.....
State of..... I hereby certify that the within instrument was filed in this office
for record on the..... day of....., 19.....

..... by
(COUNTY OFFICIAL) (DEPUTY)

Form R6-7100-57 (9/71)

FILED Sept 25, 1979
BAKER COUNTY SURVEYOR
SURVEY NO. 7-46-60