


CERTIFIED RECORD OF LAND CORNER MONUMENTATION

History of original corner establishment:

Corner established this survey.

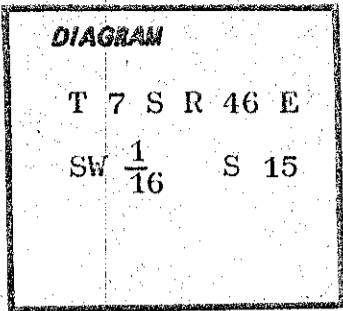

Description of corner evidence found:

Found a 2 x 2 in. wood post 30 ins. long painted yellow at the corner point.

Description of monument and accessories established to perpetuate the original location of this corner:

Set a 2½ in. brass cap on a 2 in. iron pipe 31 ins. long 27 ins. in the ground with a surrounding rock mound and a 6 foot steel fence post alongside with a sign 54-9 and 2 signs 54-2 attached.

Brass cap marked thus: T 7 S R 46 E

SW $\frac{1}{16}$ S 15
1979

ORLS 1639

New bearing trees:

A fir 14 ins. diam. bears S 28° E, 17.4 ft. dist. marked SW 1/16 S 15 BT
A fir 6 ins. diam. bears N 27° E, 23.9 ft. dist. marked SW 1/16 S 15 BT

Each new bearing tree has a sign 54-3 attached below a band of red paint and has a brass washer marked LS 1639 nailed flush with BT blaze.

I hereby certify the above corner monument was properly established by me on Sept. 7, 1979 and witnessed by Jim DeMastus and Jeff Townsend.

REGISTERED
PROFESSIONAL
LAND SURVEYOR

William L. Hanley

OREGON
JULY 14, 1978
WILLIAM L. HANLEY
1639

Office of..... County of.....
State of....., I hereby certify that the within instrument was filed in this office
for record on the..... day of....., 19.....

..... by
(COUNTY OFFICIAL) (DEPUTY)

Form R6-7100-51 (9/71)

FILED Sept. 25, 1979
BAKER COUNTY SURVEYOR
SURVEY NO. 7-46-61