


CERTIFIED RECORD OF LAND CORNER MONUMENTATION

History of original corner establishment:

Corner established this survey.

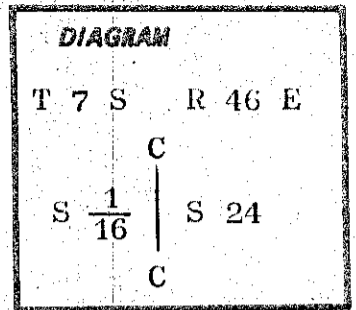


Description of corner evidence found:

None

Description of monument and accessories established to perpetuate the original location of this corner:

Set a 2½ in. brass cap on a 2 in. iron pipe 31 ins. long 26 ins. in the ground with a surrounding rock mound and a 6 foot steel fence post alongside with a sign 54-9 and 2 signs 54-2 attached.

Brass cap marked thus: T 7 S R 46 E

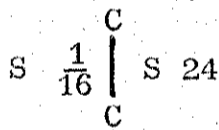

1979

ORLS 1639

There being no trees with limits I raised a mound of stone, the nearest point of which bears West, 5.5 ft. dist.

I hereby certify that the above corner monument was properly established by me on Sept. 14, 1979 and witnessed by Tom Fisk and Jeff Townsend.

REGISTERED PROFESSIONAL LAND SURVEYOR
<i>William L. Hanley</i>
OREGON JULY 14, 1978 WILLIAM L. HANLEY 1639

Office of..... County of.....
State of....., I hereby certify that the within instrument was filed in this office
for record on the..... day of....., 19.....

..... by
(COUNTY OFFICIAL) (DEPUTY)

Form R6-7100-57 (9/71)

FILED Oct 18 1979
BAKER COUNTY SURVEYOR
SURVEY NO. 7-46-63