


CERTIFIED RECORD OF LAND CORNER MONUMENTATION

History of original corner establishment:

Corner established this survey.

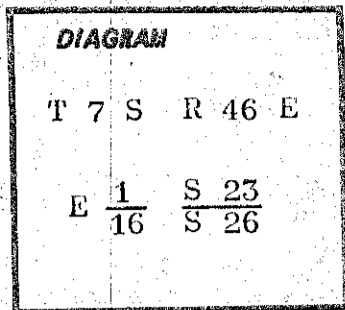

Description of corner evidence found:

A fence corner bears N 19° E., 109 ft. dist. from which the fence runs north, south and east.

Description of monument and accessories I established to perpetuate the original location of this corner:

Set a 2½ in. brass cap on a 2 in. iron pipe 31 ins. long 28 ins. in the ground with a surrounding rock mound and a 6 foot steel fence post alongside with a sign 54-9 and 2 signs 54-2 attached.

Brass cap marked thus: T 7 S R 46 E

E  $\frac{1}{16}$  S  $\frac{23}{26}$

1979

ORLS 1639

New bearing tree:

A pine 22 ins. diam. bears S 44° W., 177.9 ft. dist. marked E 1/16 S 26 BT with a sign 54-3 attached below a band of red paint and a brass washer marked LS 1639 nailed flush with BT blaze.

There being no other trees available within limits I raised a mound of stone, the nearest point of which bears west, 5.5 ft. dist.

I hereby certify that the above corner monument was properly established by me on Sept. 14, 1979 and witnessed by Tom Fisk and Jeff Townsend.

<b>REGISTERED PROFESSIONAL LAND SURVEYOR</b>
------------------------------------------------------

*William L. Hanley*

OREGON JULY 14, 1978 WILLIAM L. HANLEY
----------------------------------------------

Office of..... County of.....  
State of....., I hereby certify that the within instrument was filed in this office 1639  
for record on the..... day of....., 19.....

..... by .....  
(COUNTY OFFICIAL) (DEPUTY)

Form R6-7100-57 (9/71)

FILED Oct. 18, 1979  
BAXER COUNTY SURVEYOR  
SURVEY NO. 7-46-64