


CERTIFIED RECORD OF LAND CORNER MONUMENTATION

History of original corner establishment:

Corner established by W.B. Barr under GLO Contract No. 443 dated May 29, 1882.

Surveyor General's records state:

Set basalt rock 17 X 12 X 8 ins 12 ins in ground for corner to Sec 19, 24, 25, 30 marked with 4 notches on the North and 2 notches on the South sides; raised mound of rock alongside; pits impracticable.

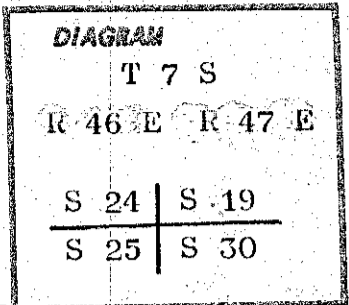

Description of corner evidence found:


Found a basalt stone 15 x 10 x 4 ins. 6 ins. in the ground, firmly set, with 2 notches on the south and 4 notches on the north sides with a mound of stone alongside.

A fence bears North, 193.0 ft. dist. and runs east and west.

Description of monument and accessories I established to perpetuate the original location of this corner:

Set a 2½ in. brass cap on a 2 in. iron pipe 31 ins. long 25 ins. in the ground to solid rock with a surrounding rock mound and a 6 foot steel fence post alongside with a sign 54-2 and 54-4 attached. Buried the original stone alongside the iron pipe monument.

Brass cap marked thus:

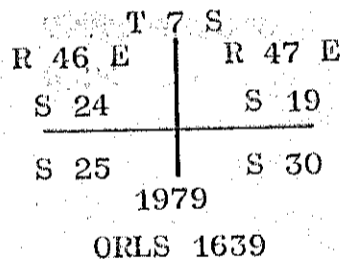

There being no trees available within limits I raised a mound of stone, the nearest point of which bears West, 5.5 ft. dist.

I hereby certify that the above corner monument was properly re-monumented by me on August 13, 1979 and witnessed by Tracy Labaree.

<b>REGISTERED PROFESSIONAL LAND SURVEYOR</b>
--

*William L. Hanley*

<b>OREGON</b> JULY 14, 1978 WILLIAM L. HANLEY 1639
---

Office of..... County of.....  
 State of....., I hereby certify that the within instrument was filed in this office  
 for record on the..... day of....., 19.....  
 ..... by .....  
 (COUNTY OFFICIAL) (DEPUTY)

Form R6-7100-57 (9/71)

FILED Oct. 18, 1979  
 BAKER COUNTY SURVEYOR  
 SURVEY NO. 7-46-65