


CERTIFIED RECORD OF LAND CORNER MONUMENTATION

History of original corner establishment:

Corner established by W. B. Barr under GLO contract No. 443 dated May 29, 1882.

Surveyor's General records state:

Set a basalt rock 12 x 12 x 10 ins. 8 ins. in the ground for corner to secs. 26, 27, 34 and 35 marked with 1 notch on the South and 2 notches on the East edges and raised a mound of rock alongside: Pits impractical.

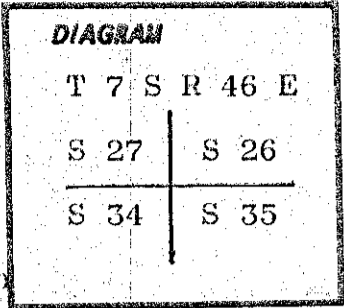


Description of corner evidence found:

A stone 18 x 10 x 5 ins. firmly set 17 ins. in the ground with 2 notches on the east face and a small mound of stone alongside. A fence line which runs north and south bears east, 2 feet distance.

Description of monument and accessories established to perpetuate the original location of this corner:

Set a 2½ in. brass cap on a 2 in. iron pipe 31 ins. long 28 ins. in the ground with a surrounding rock mound and a 6 foot steel fence post alongside with a sign 54-4 attached. Buried original stone alongside.

Brass cap marked thus: T 7 S R 46 E

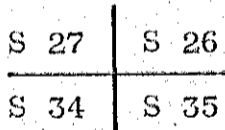

1979

ORLS 1639

New bearing trees:

- A pine 20 ins. diam. bears S 03° E., 184.2 ft. dist. mkd T 7 S R 46 E S 35 BT
- A pine 22 ins. diam. bears S 57° W., 112.3 ft. dist. mkd T 7 S R 46 E S 34 BT
- A pine 24 ins. diam. bears N 84° W., 248.5 ft. dist. mkd T 7 S R 46 E S 27 BT

Each new bearing tree has a sign 54-3 attached below a band of red paint and has a brass washer nailed flush with BT blaze and marked LS 1639.

There being no other trees available within limits I raised a mound of stone, the nearest point of which bears West, 5.5 ft. dist.

I hereby certify the above corner was properly remonumented by me on August 8, 1979, witnessed by Jim DeMastus.

Office of..... County of.....
 State of..... I hereby certify that the within instrument was filed in this office
 for record on the..... day of....., 19.....

..... by
 (COUNTY OFFICIAL) (DEPUTY)

REGISTERED
 PROFESSIONAL
 LAND SURVEYOR

William L Hanley

OREGON
 JULY 14, 1978
 WILLIAM L. HANLEY
 ☆ GPO-1639-276

Form R6-7100-57 (9/71)

FILED Oct. 23, 1979
 BAKER COUNTY SURVEYOR
 SURVEY NO. 7-46-66