


CERTIFIED RECORD OF LAND CORNER MONUMENTATION

History of original corner establishment:

Corner established by W.B. Barr under GLO Contract No. 443 dated May 29, 1882.

Surveyor General's records state:

Set basalt rock 14 X 12 X 4 ins 10 ins in ground for 1/4 Sec corner marked 1/4 on the North side and raised mound of rock alongside; pits impracticable.

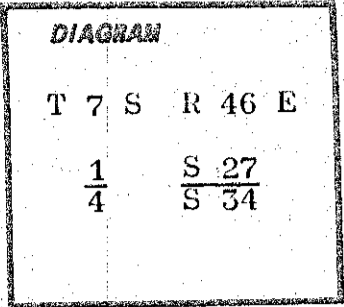

Description of corner evidence found:

None

Description of monument and accessories established to perpetuate the original location of this corner:

Set a 2½ in. brass cap on a 2 in. iron pipe 31 ins. long 27 ins. in the ground with a surrounding rock mound and a 6 foot steel fence post alongside with a sign 54-4 attached.

Brass cap marked thus: T 7 S R 46 E

$\frac{1}{4}$ $\frac{S 27}{S 34}$

1979.

ORLS 1639

There being no trees available within limits, I raised a mound of stone, the nearest point of which bears South, 5.5 ft. dist.

A rock 56 x 40 ins. and projecting 40 ins. above the ground bears N 55° E., 87.7 ft. dist. marked X on its top and B0 on the west face.

I hereby certify that the above corner monument was properly re-established by me on August 8, 1979 and witnessed by Jim DeMastus.

REGISTERED
PROFESSIONAL
LAND SURVEYOR

William L Hanley

OREGON
JULY 14, 1978
WILLIAM L. HANLEY
1639

Office of..... County of.....
State of..... I hereby certify that the within instrument was filed in this office
for record on the..... day of....., 19.....
..... by
(COUNTY OFFICIAL) (DEPUTY)

Form R6-7100-57 (9/71)

FILED Oct. 23, 1979
BAKER COUNTY SURVEYOR
SURVEY NO. 7-46-67