

CERTIFIED RECORD OF LAND CORNER MONUMENTATION


History of original corner establishment:

Corner established by W.B. Barr under GLO Contract No. 443 dated May 29, 1882.

Surveyor General's records state:

Set basalt rock 15 X 10 X 6 ins 10 ins in ground for 1/4 Sec corner marked 1/4 on the North side from which:

A pine 8 ins diam bears N 78° W 12 lks dist mkd 1/4 S BT  
 A pine 24 ins diam bears S 21° E 98 lks dist mkd 1/4 S BT

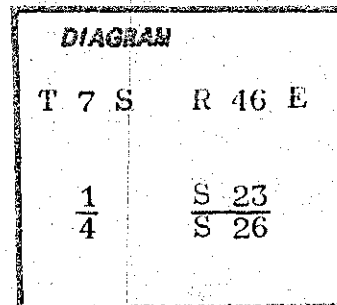

Description of corner evidence found:

A pine 30 ins. diam. with healed blaze for Section 23 bearing tree.  
 A basalt stone 15 x 12 x 6 ins. lying alongside the Section 23 bearing tree with a 4 chisled on its top.

Description of monument and accessories established to perpetuate the original location of this corner:

Set a 2½ in. brass cap on a 2 in. iron pipe 31 ins. long 28 ins. in the ground at the position as located by the Section 23 bearing tree with a surrounding rock mound and a 6 foot steel fence post alongside with a sign 54-4 attached. Buried original stone alongside.

Brass cap marked thus: T 7 S R 46 E

$\frac{1}{4}$        $\frac{S\ 23}{S\ 26}$

1979

ORLS 1639

New bearing tree:

A pine 24 ins. diam. bears S 78° E., 178.0 ft. dist. marked 1/4 S 26 BT, with a sign 54-3 attached below a band of red paint and a brass washer marked LS 1639 nailed flush with BT blaze.

The original bearing tree also has a sign 54-3 attached below a band of red paint.

I hereby certify that the above corner monument was properly re-established by me on August 8, 1979 and witnessed by Jim DeNastus.

REGISTERED  
PROFESSIONAL  
LAND SURVEYOR

*William L. Hanley*

OREGON  
JULY 14, 1978  
WILLIAM L. HANLEY  
1639

Office of..... County of.....  
 State of....., I hereby certify that the within instrument was filed in this office  
 for record on the..... day of....., 19.....  
 ..... by .....  
 (COUNTY OFFICIAL) (DEPUTY)

Form R6-7100-57 (9/71)

FILED OCT. 23, 1979  
 BAKER COUNTY SURVEYOR  
 SURVEY NO. 7-46-69