


CERTIFIED RECORD OF LAND CORNER MONUMENTATION

History of original corner establishment:

Corner established by W.B. Barr under GLO Contract No. 443 dated May 29, 1882.


Surveyor General's records state:

Set lava rock 18 X 10 X 4 ins 12 ins in ground for corner to sec 27, 28, 33, 34 marked with 1 notch on the South and 3 notches on the East edges and raised mound of rock alongside; pits impracticable.

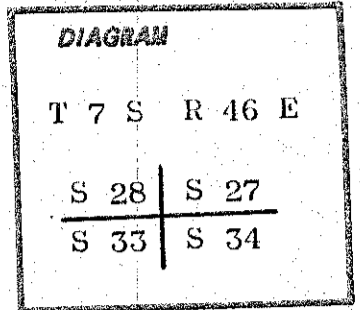

Description of corner evidence found:

A 2½ in. brass cap on a 2 in. iron pipe firmly set with a surrounding rock mound marked thus:

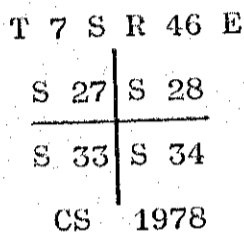

Description of monument and accessories I established to perpetuate the original location of this corner:

Set a 6 foot steel fence post alongside existing brass cap monument with a sign 54-4 attached and improved surrounding rock mound.

There being no trees available within limits I raised a mound of stone, the nearest point of which bears West, 5.5 ft. dist.

Bearing objects established:

A basalt rock, 30 x 30 ins. and projecting 50 ins. out of the ground bears S 47° E., 98.0 ft. dist. marked X on top and BO on west face.

A basalt rock 50 x 40 ins. and projecting 60 ins. out of the ground bears N 37° W., 79.0 ft. dist. marked X on top and BO on the south-east face.

I hereby certify that the above corner monument was properly perpetuated by me on August 8, 1979 and witnessed by Jim DeMastus.

REGISTERED PROFESSIONAL LAND SURVEYOR
<i>William L. Hanley</i>
OREGON JULY 14, 1978 WILLIAM L. HANLEY 1639

Office of..... County of.....  
 State of....., I hereby certify that the within instrument was filed in this office  
 for record on the..... day of....., 19.....  
 ..... by .....  
 (COUNTY OFFICIAL) (DEPUTY)

Form R6-7100-57 (9/71)

FILED OCT. 23, 1979  
 BAKER COUNTY SURVEYOR  
 SURVEY NO. 7-46-70