


CERTIFIED RECORD OF LAND CORNER MONUMENTATION

History of original corner establishment:

Corner established by W. B. Barr under GLO contract No. 443 dated May 29, 1882.

Surveyor's General records state:

Set a basalt stone 12 x 10 x 8 ins. 8 ins. in the ground for 1/4 Sec. Cor. marked 1/4 on W side and raised mound of rock alongside: pits impractical.

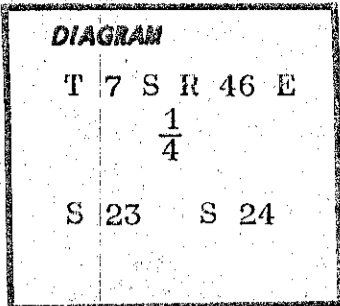


Description of corner evidence found:

None

Description of monument and accessories established to perpetuate the original location of this corner:

Set a 2½ in. brass cap on a 2 in. iron pipe 31 ins. long 21 ins. in the ground to solid rock with a surrounding rock mound and a 6 foot steel fence post alongside with a sign 54-4 and 2 signs 54-2 attached.

Brass cap marked thus: T 7 S R 46 E

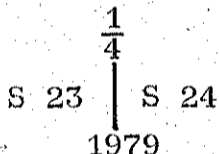

ORLS 1639

A pine 16 ins. diam. bears S 46° W., 155.9 ft. dist. marked 1/4 S 23 BT with a sign 54-3 attached below a band of red paint and a brass washer marked LS 1639 nailed flush with BT blaze.

There being no other trees available within limits, I raised a mound of stone, the nearest point of which bears East, 5.5 ft. dist.

I hereby certify that the above corner monument was properly re-established by me on August 17, 1979 and witnessed by Tracy Labaree and Jim DeMastus.

REGISTERED  
PROFESSIONAL  
LAND SURVEYOR

*William L. Hanley*

OREGON  
JULY 14, 1978  
WILLIAM L. HANLEY  
1639

Office of..... County of.....  
 State of..... I hereby certify that the within instrument was filed in this office  
 for record on the..... day of....., 19.....  
 ..... by .....  
 (COUNTY OFFICIAL) (DEPUTY)

Form R6-7100-57 (9/71)

FILED Oct. 23, 1979  
 BAKER COUNTY SURVEYOR  
 SURVEY NO. 7-46-71